


1 LOCATION OF WATER WELL: Fraction SE 1/4 #11 1/4 SE 1/4 Section Number 25 Township Number T 6 S Range Number R 42 EW  
 County: Sherman

Distance and direction from nearest town or city street address of well, if located within city?  
10N - 4E of Kanorado

2 WATER WELL OWNER: Darlene Kirby  
 RR#, St. Address, Box #: HCR 3 - Box 500 Board of Agriculture, Division of Water Resources  
 City, State, ZIP Code: Goodland KS 67735 Application Number:

3 LOCATE WELL'S LOCATION WITH AN "X" IN SECTION BOX: 4 DEPTH OF COMPLETED WELL: 290 ft. ELEVATION:  
 Depth(s) Groundwater Encountered 1. 166 ft. 2. 166 ft. 3. 166 ft.

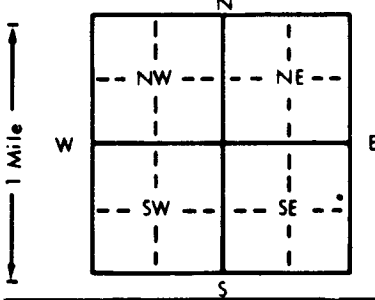

WELL'S STATIC WATER LEVEL 166 ft. below land surface measured on mo/day/yr  
 Pump test data: Well water was \_\_\_\_\_ ft. after \_\_\_\_\_ hours pumping \_\_\_\_\_ gpm  
 Est. Yield 20 gpm: Well water was \_\_\_\_\_ ft. after \_\_\_\_\_ hours pumping \_\_\_\_\_ gpm  
 Bore Hole Diameter 8 in. to 290 ft., and \_\_\_\_\_ in. to \_\_\_\_\_ ft.  
 WELL WATER TO BE USED AS: 5 Public water supply 8 Air conditioning 11 Injection well  
 1 Domestic 3 Feedlot 6 Oil field water supply 9 Dewatering 12 Other (Specify below)  
 2 Irrigation 4 Industrial 7 Lawn and garden only 10 Monitoring well  
 Was a chemical/bacteriological sample submitted to Department? Yes No If yes, mo/day/yr sample was sub-  
 mitted Water Well Disinfected? Yes Yes No

5 TYPE OF BLANK CASING USED: 5 Wrought iron 8 Concrete tile CASING JOINTS: Glued \_\_\_\_\_ Clamped \_\_\_\_\_  
 1 Steel 3 RMP (SR) 6 Asbestos-Cement 9 Other (specify below) Welded \_\_\_\_\_  
 2 PVC 4 ABS 7 Fiberglass Threaded \_\_\_\_\_

Blank casing diameter 4.5 in. to 270 ft. Dia \_\_\_\_\_ in. to \_\_\_\_\_ ft. Dia \_\_\_\_\_ in. to \_\_\_\_\_ ft.  
 Casing height above land surface 12 in., weight 160 lbs./ft. Wall thickness or gauge No. 5DR26

TYPE OF SCREEN OR PERFORATION MATERIAL: 10 Asbestos-cement  
 1 Steel 3 Stainless steel 5 Fiberglass 8 RMP (SR) 11 Other (specify) \_\_\_\_\_  
 2 Brass 4 Galvanized steel 6 Concrete tile 9 ABS 12 None used (open hole)

SCREEN OR PERFORATION OPENINGS ARE: 5 Gauzed wrapped 8 Saw cut 11 None (open hole)  
 1 Continuous slot 3 Mill slot 6 Wire wrapped 9 Drilled holes  
 2 Louvered shutter 4 Key punched 7 Torch cut 10 Other (specify) \_\_\_\_\_

SCREEN-PERFORATED INTERVALS: From 270 ft. to 290 ft. From \_\_\_\_\_ ft. to \_\_\_\_\_ ft.  
8-12 Silver Sand From \_\_\_\_\_ ft. to \_\_\_\_\_ ft. From \_\_\_\_\_ ft. to \_\_\_\_\_ ft.  
 GRAVEL PACK INTERVALS: From 230 ft. to 290 ft. From \_\_\_\_\_ ft. to \_\_\_\_\_ ft.  
Returns From 20 ft. to 230 ft. From \_\_\_\_\_ ft. to \_\_\_\_\_ ft.

6 GROUT MATERIAL: 1 Neat cement 2 Cement grout 3 Bentonite 4 Other \_\_\_\_\_  
 Grout Intervals: From 0 ft. to 20 ft. From \_\_\_\_\_ ft. to \_\_\_\_\_ ft. From \_\_\_\_\_ ft. to \_\_\_\_\_ ft.

What is the nearest source of possible contamination: 10 Livestock pens 14 Abandoned water well  
 1 Septic tank 4 Lateral lines 7 Pit privy 11 Fuel storage 15 Oil well/Gas well  
 2 Sewer lines 5 Cess pool 8 Sewage lagoon 12 Fertilizer storage 16 Other (specify below)  
 3 Watertight sewer lines 6 Seepage pit 9 Feedyard 13 Insecticide storage

Direction from well? None in Site How many feet?

FROM	TO	LITHOLOGIC LOG	FROM	TO	PLUGGING INTERVALS
0	20	<del>Sand &amp; Clay</del>	290	20	<u>We PROPERLY Plugged the old existing well by FILLING with SAND and 20' Cement Plug.</u>
20	70	<del>Clay</del>	20	0	
70	90	<del>gravel &amp; Sand</del>			
90	120	<del>gravel &amp; Sand &amp; clay</del>			
120	180	<del>Sand &amp; clay</del>			
180	200	<del>gravel layer sand &amp; clay</del>			
200	220	<del>gravel layer sand &amp; clay</del>			
220	240	<del>Sand &amp; clay</del>			
240	290	<del>gravel &amp; sand</del>			
	290	<u>Shale</u>			

7 CONTRACTOR'S OR LANDOWNER'S CERTIFICATION: This water well was (1) constructed, (2) reconstructed, or (3) plugged under my jurisdiction and was completed on (mo/day/year) 7-16-97 and this record is true to the best of my knowledge and belief. Kansas Water Well Contractor's License No. 1587 This Water Well Record was completed on (mo/day/yr) 7-28-97 under the business name of School Drilling Co. by (signature) Darlene Kirby