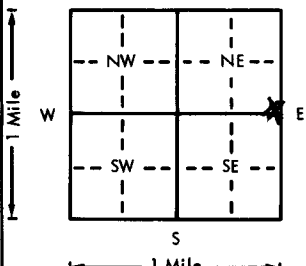


USE TYPEWRITER OR BALL POINT PEN-PRESS FIRMLY, PRINT CLEARLY.

WATER WELL RECORD
KSA 82a-1201-1215

Kansas Department of Health and Environment-Division of Environment
(Water well Contractors)
Topeka, Kansas 66620

ADD

1. Location of well:		County SHERMAN	Fraction SE 1/4 SE 1/4 NE 1/4	Section number 4	Township number T 6 S R 42	Range number 10W
2. Distance and direction from nearest town or city: Rulinton			3. Owner of well: Keith Bracelin			
Street address of well location if in city: 6 W. 16th 15th N			R.R. or street: Hy 27			
4. Locate with "X" in section below:			City, state, zip code: Goodland Kansas 67228			
Sketch map: 			6. Bore hole dia. 4 in. Completion date 9-3-77 Well depth 258.5			
5. Type and color of material			7. Cable tool <input checked="" type="checkbox"/> Rotary <input type="checkbox"/> Driven <input type="checkbox"/> Dug <input type="checkbox"/> Hollow rod <input type="checkbox"/> Jetted <input type="checkbox"/> Bored <input type="checkbox"/> Reverse rotary			
			8. Use: <input type="checkbox"/> Domestic <input type="checkbox"/> Public supply <input type="checkbox"/> Industry <input type="checkbox"/> Irrigation <input type="checkbox"/> Air conditioning <input checked="" type="checkbox"/> Stock <input type="checkbox"/> Lawn <input type="checkbox"/> Oil field water <input type="checkbox"/> Other			
			9. Casing: Material FRP Weight: Above or below Threaded <input type="checkbox"/> Welded <input type="checkbox"/> Surface 12 in. RMP <input type="checkbox"/> PVC <input checked="" type="checkbox"/> Weight 15 lbs./ft. Dia. 4 in. to 225.5 depth! Wall Thickness: inches or Dia. <input type="checkbox"/> in. to <input type="checkbox"/> ft. depth! gauge No. 1237			
			10. Screen: Manufacturer's name JESS + LOWELL Type LOWELL Dia. 5 Slot/gauze 18 x .258 Length 28 Set between 225.5 ft. and 233.5 ft. <input type="checkbox"/> ft. and <input type="checkbox"/> ft. Gravel pack? <input checked="" type="checkbox"/> Size range of material 1/8			
			11. Static water level: <input type="checkbox"/> mo./day/yr. 156 ft. below land surface Date 8-30-77			
			12. Pumping level below land surfaces: 190 ft. after 3 hrs. pumping 15 g.p.m. <input type="checkbox"/> ft. after <input type="checkbox"/> hrs. pumping <input type="checkbox"/> g.p.m. Estimated maximum yield 50 g.p.m.			
			13. Water sample submitted: <input type="checkbox"/> mo./day/yr. Yes <input checked="" type="checkbox"/> No <input type="checkbox"/> Date <input type="checkbox"/>			
			14. Well head completion: <input type="checkbox"/> Pitless adapter <input type="checkbox"/> inches above grade			
			15. Well grouted? <input checked="" type="checkbox"/> Yes With: <input type="checkbox"/> Neat cement <input type="checkbox"/> Bentonite <input checked="" type="checkbox"/> Concrete Depth: From 0 ft. to 10 ft.			
			16. Nearest source of possible contamination: PASTURE ft. <input type="checkbox"/> Direction <input type="checkbox"/> Type PASTURE Well disinfected upon completion? <input checked="" type="checkbox"/> Yes <input type="checkbox"/> No			
			17. Pump: <input type="checkbox"/> Not installed Manufacturer's name DEWATER Model number 2 1/2 x 16 HP <input type="checkbox"/> Volts <input type="checkbox"/> Length of drop pipe 255 ft. capacity 5 g.p.m. Type: <input type="checkbox"/> Submersible <input type="checkbox"/> Turbine <input type="checkbox"/> Jet <input checked="" type="checkbox"/> Reciprocating <input type="checkbox"/> Centrifugal <input type="checkbox"/> Other			
18. Elevation:			20. Water well contractor's certification: This well was drilled under my jurisdiction and this report is true to the best of my knowledge and belief Bill Dillingdale Inc 166 Business name Goodland Kansas License No. <input type="checkbox"/> Address Goodland Kansas Signed Bill Dillingdale Date 9-6-77 Authorized representative			
19. Remarks: 3770 (TOPO)						

T-6 420-4 SE SE NE 1/4 1/4 1/4