

USE TYPEWRITER OR BALL POINT PEN—PRESS FIRMLY, PRINT CLEARLY.


WATER WELL RECORD  
KSA 82a-1201-1215

Kansas Department of Health and Environment—Division of Environment  
(Water well Contractors)  
Topeka, Kansas 66620

*DOB* *DDC*

1. Location of well:	County <b>Sherman</b>	Fraction <b>NW 1/4 SW 1/4 SE 1/4</b>	Section number <b>5</b>	Township number <b>T 6 S R 42 E 10</b>	Range number
----------------------	--------------------------	---	----------------------------	---	--------------

2. Distance and direction from nearest town or city: <b>15 miles north, 3/4 miles east of Kanorado, Kansas</b> Street address of well location if in city:	3. Owner of well: <b>Bluford Kellner</b> R.R. or street: City, state, zip code: <b>Kanorado, Kansas 67741</b>
---	---

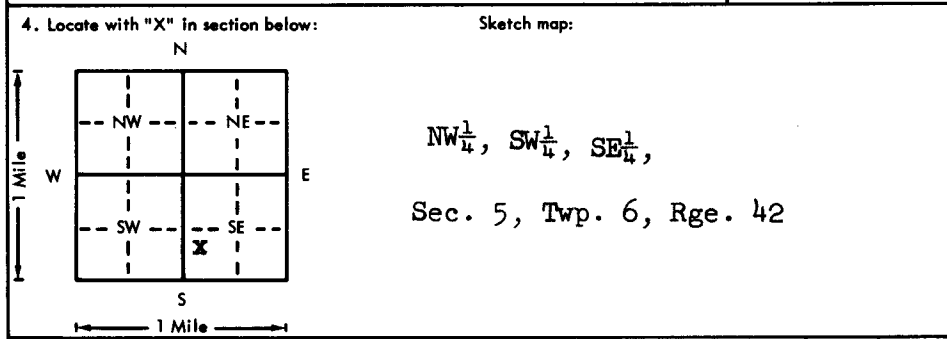

6. Bore hole dia. <b>30</b> in. Completion date <b>4-8-76</b> Well depth <b>280</b> ft.
7. <input type="checkbox"/> Cable tool <input type="checkbox"/> Rotary <input type="checkbox"/> Driven <input type="checkbox"/> Dug <input type="checkbox"/> Hollow rod <input type="checkbox"/> Jetted <input type="checkbox"/> Bored <input checked="" type="checkbox"/> Reverse rotary
8. Use: <input type="checkbox"/> Domestic <input type="checkbox"/> Public supply <input type="checkbox"/> Industry <input checked="" type="checkbox"/> Irrigation <input type="checkbox"/> Air conditioning <input type="checkbox"/> Stock <input type="checkbox"/> Lawn <input type="checkbox"/> Oil field water <input type="checkbox"/> Other
9. Casing: Material <u>steel</u> Height: <u>Above</u> or below Threaded <input type="checkbox"/> Welded <input checked="" type="checkbox"/> Surface <u>12</u> in. RMP <input type="checkbox"/> PVC <input type="checkbox"/> Weight <u>36</u> lbs./ft. Dia. <u>16</u> in. to <u>280</u> depth Wall Thickness: inches or Dia. <input type="checkbox"/> in. to <input type="checkbox"/> ft. depth gage No. <u>219</u>

5. Type and color of material	From	To
clay sand and streaks hard rock	0	220
medium sands loose clean	220	223
clay rock and sand streaks	223	250
good fine loose and clean	250	253
clay and rock	253	258
good fine to medium loose clean	258	268
soapstone	268	280
<i>BRICK 368'</i>		
(Use a second sheet if needed)		

10. Screen: Manufacturer's name <u>W. A. Brown</u> Type <u>steel</u> Dia. <u>16"</u> Slot/gauze <u>2"</u> Length <u>160'</u> Set between <u>120</u> ft. and <u>280</u> ft. <u>ft.</u> and <u>ft.</u> Gravel pack? <input checked="" type="checkbox"/> <u>yes</u> Size range of material <u>3/8</u>
11. Static water level: <u>170</u> ft. below land surface Date <u>4-11-76</u> mo./day/yr.
12. Pumping level below land surfaces: <u>263</u> ft. after <u>8</u> hrs. pumping <u>390</u> g.p.m. <u>ft.</u> after <u>hrs.</u> pumping <u>g.p.m.</u> Estimated maximum yield <u>390</u> g.p.m.
13. Water sample submitted: <u>Yes</u> <input checked="" type="checkbox"/> <u>No</u> <input type="checkbox"/> Date
14. Well head completion: <input type="checkbox"/> Pitless adapter <u>12</u> inches above grade
15. Well grouted? <input checked="" type="checkbox"/> <u>yes</u> With: <input checked="" type="checkbox"/> Neat cement <input type="checkbox"/> Bentonite <input type="checkbox"/> Concrete Depth: From <u>0</u> ft. to <u>10</u> ft.
16. Nearest source of possible contamination: <u>none</u> ft. <u>ft.</u> Direction <u>ft.</u> Type <u>ft.</u> Well disinfected upon completion? <input type="checkbox"/> Yes <input type="checkbox"/> No
17. Pump: <input checked="" type="checkbox"/> Not installed Manufacturer's name <u>HP</u> <u>Volts</u> Model number <u>HP</u> <u>Volts</u> Length of drop pipe <u>ft.</u> capacity <u>g.p.m.</u> Type: <input type="checkbox"/> Submersible <input type="checkbox"/> Turbine <input type="checkbox"/> Jet <input type="checkbox"/> Reciprocating <input type="checkbox"/> Centrifugal <input type="checkbox"/> Other

18. Elevation:  Topography: <input type="checkbox"/> Hill <input checked="" type="checkbox"/> Slope <input type="checkbox"/> Upland <input type="checkbox"/> Valley	19. Remarks:  <i>3777 (TOPU)</i> <i>3809</i>
---	---

20. Water well contractor's certification: This well was drilled under my jurisdiction and this report is true to the best of my knowledge and belief. <b>Northwest Drilling Co., Inc.</b> Business name <u>Northwest Drilling Co., Inc.</u> License No. <u>248</u> Address <u>PO Box 411 Goddland, Kansas</u> 67735 Signed <u>[Signature]</u> Date <u>7-13-76</u> Authorized representative
--

T-6  
 R-42  
 S-5  
 NW  
 SE  
 SW  
 NE