


1 LOCATION OF WATER WELL: Fraction SW 1/4 SW 1/4 NW 1/4 Section Number 10 Township Number T 6 S Range Number R 42 E

Distance and direction from nearest town or city street address of well if located within city?
14 MI 1/2 E OF KANORADO

2 WATER WELL OWNER: GREGORY BELLAMY
RR#, St. Address, Box #: Rt 3 Box 700 Board of Agriculture, Division of Water Resources
City, State, ZIP Code: COLBY, KS 67201 Application Number:

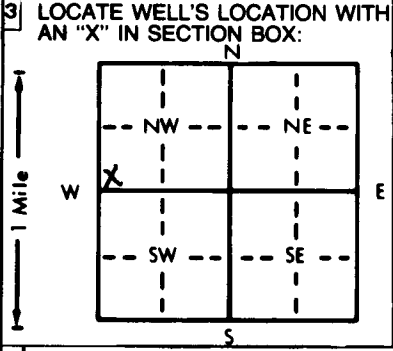

4 DEPTH OF COMPLETED WELL X 200 ft. ELEVATION: _____
Depth(s) Groundwater Encountered 1. _____ ft. 2. _____ ft. 3. _____ ft.
WELL'S STATIC WATER LEVEL X 150 ft. below land surface measured on mo/day/yr _____
Pump test data: Well water was _____ ft. after _____ hours pumping _____ gpm
Est. Yield _____ gpm: Well water was _____ ft. after _____ hours pumping _____ gpm
Bore Hole Diameter _____ in. to _____ ft., and _____ in. to _____ ft.
WELL WATER TO BE USED AS: 5 Public water supply 8 Air conditioning 11 Injection well
① Domestic 3 Feedlot 6 Oil field water supply 9 Dewatering 12 Other (Specify below)
2 Irrigation 4 Industrial 7 Lawn and garden only 10 Monitoring well _____
Was a chemical/bacteriological sample submitted to Department? Yes _____ No _____; If yes, mo/day/yr sample was submitted _____
Water Well Disinfected? Yes _____ No _____

5 TYPE OF BLANK CASING USED: X
① Steel 3 RMP (SR) 5 Wrought iron 8 Concrete tile CASING JOINTS: Glued _____ Clamped _____
2 PVC 4 ABS 6 Asbestos-Cement 9 Other (specify below) Welded _____
Blank casing diameter X 6 in. to 200 ft., Dia _____ in. to _____ ft., Dia _____ in. to _____ ft.
Casing height above land surface 10 in., weight _____ lbs./ft. Wall thickness or gauge No. _____
TYPE OF SCREEN OR PERFORATION MATERIAL: 7 PVC 10 Asbestos-cement
1 Steel 3 Stainless steel 5 Fiberglass 8 RMP (SR) 11 Other (specify) _____
2 Brass 4 Galvanized steel 6 Concrete tile 9 ABS 12 None used (open hole)
SCREEN OR PERFORATION OPENINGS ARE: 5 Gauzed wrapped 8 Saw cut 11 None (open hole)
1 Continuous slot 3 Mill slot 6 Wire wrapped 9 Drilled holes
2 Louvered shutter 4 Key punched 7 Torch cut 10 Other (specify) _____
SCREEN-PERFORATED INTERVALS: From _____ ft. to _____ ft., From _____ ft. to _____ ft.
GRAVEL PACK INTERVALS: From _____ ft. to _____ ft., From _____ ft. to _____ ft.

6 GROUT MATERIAL: ① Neat cement 2 Cement grout 3 Bentonite 4 Other _____
Grout Intervals: From 6 ft. to 3 ft., From _____ ft. to _____ ft., From _____ ft. to _____ ft.
What is the nearest source of possible contamination:
1 Septic tank 4 Lateral lines 7 Pit privy 10 Livestock pens 14 Abandoned water well
2 Sewer lines 5 Cess pool 8 Sewage lagoon 11 Fuel storage 15 Oil well/Gas well
3 Watertight sewer lines 6 Seepage pit 9 Feedyard 12 Fertilizer storage 16 Other (specify below) None
13 Insecticide storage _____
Direction from well? _____ How many feet? _____

FROM	TO	LITHOLOGIC LOG	FROM	TO	PLUGGING INTERVALS
0	3	01 Clay		X	PLUGGING DESCRIPTION
3	6	25 Cement			
6	200	01 Clay			FILLED OLD WELL WITH DIRT TO WITHIN 4-5 FT. OF TOP THEN FINISHED WITH SAND THEN CAPPED IT OFF WITH LAST FOOT OR SO WITH CEMENT.
					Post Plugging Verify OK - Plumber 3-10-89

7 CONTRACTOR'S OR LANDOWNER'S CERTIFICATION: This water well was (1) constructed, (2) reconstructed, or ③ plugged under my jurisdiction and was completed on (mo/day/year) 2-1-89 and this record is true to the best of my knowledge and belief. Kansas Water Well Contractor's License No. _____ This Water Well Record was completed on (mo/day/yr) X 3-10-89 under the business name of _____ by (signature) X Greg S. Bellamy