

USE TYPEWRITER OR BALL POINT PEN-PRESS FIRMLY, PRINT CLEARLY.


WATER WELL RECORD
KSA 82a-1201-1215

Kansas Department of Health and Environment-Division of Environment
(Water well Contractors)
Topeka, Kansas 66620

AAC

1. Location of well: County **SHERMAN** Fraction **SW 1/4 NE 1/4 NE 1/4** Section number **12** Township number **T 6 S** Range number **R 42** (4W)

2. Distance and direction from nearest town or city: **3 1/2 N 1/2 N**
Street address of well location if in city: **OF KANORADO, KAN.**
3. Owner of well: **Mrs. Maurine Ehlich**
R.R. or street: **1520 Holmes Dr.**
City, state, zip code: **Colo Springs, Colo 80909**

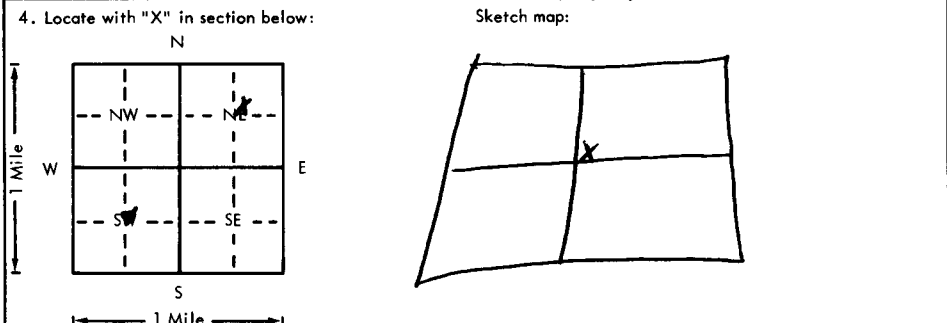

6. Bore hole dia. **10** in. Completion date **4-27-78**
Well depth **286** ft.

7. Cable tool Rotary Driven Dug
 Hollow rod Jetted Bored Reverse rotary

8. Use: Domestic Public supply Industry
 Irrigation Air conditioning Stock
 Lawn Oil field water Other

9. Casing: Material **STEEL** Height: Above or below
Threaded Welded Surface **12** in.
RMP PVC Weight **8.12** lbs./ft.
Dia. **4 1/2** in. to **246** ft. depth Wall Thickness: inches or
Dia. in. to ft. depth gage No. **179**

5. Type and color of material	From	To
Clay Sandstone Sandyclay & Gravel	0	172
Gravel	172	178
Sandyclay	178	194
Sand	194	200
Sandyclay	200	216
Sand	216	228
Sandstone	228	232
Sand	232	268
Sandyclay	268	273
Soapstone	273	286
Shale	286	288
(Use a second sheet if needed)		

10. Screen: Manufacturer's name **DOBRCR.S**
Type **slot** Dia. **4 1/2**
Slot/gauze **432** Length **40**
Set between **246** ft. and **286** ft.
 ft. and ft.
Gravel pack? Size range of material **48**

11. Static water level: mo./day/yr.
160 ft. below land surface Date **4-27-78**

12. Pumping level below land surfaces:
165 ft. after **10** hrs. pumping **5** g.p.m.
 ft. after hrs. pumping g.p.m.
Estimated maximum yield **10** g.p.m.

13. Water sample submitted: mo./day/yr.
 Yes No Date

14. Well head completion:
 Pitless adapter **NONE** inches above grade

15. Well grouted?
With: Neat cement Bentonite Concrete
Depth: From **12"** to **10** ft. **below**

16. Nearest source of possible contamination:
ft. Direction Type
Well disinfected upon completion? Yes No

17. Pump: Not installed
Manufacturer's name **Dempster**
Model number HP Volts
Length of drop pipe **188** ft. capacity **5** g.p.m.
Type:
 Submersible Turbine
 Jet Reciprocating
 Centrifugal Other

18. Elevation:
Topography: Hill Slope Upland Valley

19. Remarks:
Concrete was Run By Foust Supply Co Inc.

20. Water well contractor's certification:
This well was drilled under my jurisdiction and this report is true to the best of my knowledge and belief.
Faust Supply Co Inc 144
Business name License No.
Address **Box 338 Goodland, Kans**
Signed **Ralph E. Brown** Date **6-6-78**
Authorized representative