


USE TYPEWRITER OR BALL POINT PEN. PRESS FIRMLY, PRINT CLEARLY.

WATER WELL RECORD
KSA 82a-1201-1215

Kansas Department of Health and Environment - Division of Environment
(Water well Contractors)
Topeka, Kansas 66620

1. Location of well: County SHERMAN Fraction NE 1/4 NW 1/4 SE 1/4 Section number 16 Township number T 6 S R 42 E/W Range number 42

2. Distance and direction from nearest town or city: _____
Street address of well location if in city: _____
3. Owner of well: ED SCHULTE
R.R. or street: _____
City, state, zip code: STRATTON, Colo

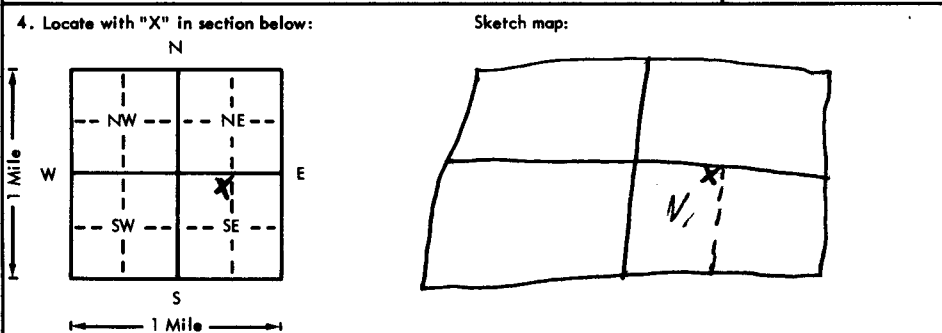

6. Bore hole dia. 16 in. Completion date 3-5-75
Well depth 318 ft.
7. Cable tool Rotary Driven Dug
 Hollow rod Jetted Bored Reverse rotary
8. Use: Domestic Public supply Industry
 Irrigation Air conditioning Stock
 Lawn Oil field water Other
9. Casing: Material Steel Height: Above or below
Threaded Welded Surface 8 in.
RMP PVC Weight _____ lbs./ft.
Dia. 16 in. to 318 ft. depth Wall Thickness: inches or
Dia. _____ in. to _____ ft. depth gage No. _____

5. Type and color of material	From	To
Top Soil	0	51
Sandstone	51	61
Gravel	61	113
Clay & Gravel	113	147
Sandstone	147	161
Gravel	161	164
Clay & Sandstone	164	176
Gravel	176	192
Sandstone	192	194
Gravel	194	196
Sandstone & Clay	196	224
Gravel	224	233
Clay & Sandstone	233	253
Gravel	253	256
Clay & Sandstone	256	265

10. Screen: Manufacturer's name W.A. Brown
Type Mill Salt Dia. 1 1/2"
Slot/gauze _____ Length 20'
Set between 198 ft. and 318 ft.
_____ ft. and _____ ft.
Gravel pack? Size range of material 1/4 to 1/2"
11. Static water level: _____ mo./day/yr.
165 ft. below land surface Date 3-5-75
12. Pumping level below land surfaces:
300 ft. after 8 hrs. pumping 600 g.p.m.
_____ ft. after _____ hrs. pumping _____ g.p.m.
Estimated maximum yield 600 g.p.m.
13. Water sample submitted: _____ mo./day/yr.
Yes No Date _____
14. Well head completion:
_____ Pitless adapter _____ Inches above grade
15. Well grouted?
With: Neat cement Bentonite Concrete
Depth: From 10 ft. to 8" above.
16. Nearest source of possible contamination:
ft. _____ Direction _____ Type _____
Well disinfected upon completion? _____ Yes _____ No
17. Pump: _____ Not installed
Manufacturer's name TAIT A+C
Model number _____ HP _____ Volts _____
Length of drop pipe 300 ft. capacity 600 g.p.m.
Type:
 Submersible Turbine
 Jet Reciprocating
 Centrifugal Other

18. Elevation: _____
19. Remarks: Concrete Slab was run 25830 (TUPD)
when well was drilled
Ralph Elman mg.
(Use a second sheet if needed)

20. Water well contractor's certification:
This well was drilled under my jurisdiction and this report is true to the best of my knowledge and belief.
Business name Faust Sulphy Co. Inc. 1/4
Address Box 338 Goodland, Kans
Signed Ralph Elman mg. Date 3-8-75
Authorized representative

-6 42E 16 NE NW SW
R
Sec

USE TYPEWRITER OR BALL POINT PEN—PRESS FIRMLY, PRINT CLEARLY.

WATER WELL RECORD
KSA 82a-1201-1215

Kansas Department of Health and Environment—Division of Environment
(Water well Contractors)
Topeka, Kansas 66620

1. Location of well:	County	Fraction 1/4 1/4 1/4	Section number	Township number T S R	Range number E/W
2. Distance and direction from nearest town or city: Street address of well location if in city:			3. Owner of well: R.R. or street: City, state, zip code:		
4. Locate with "X" in section below: N		Sketch map:		6. Bore hole dia. _____ in. Completion date _____ Well depth _____ ft.	
				7. ___ Cable tool ___ Rotary ___ Driven ___ Dug ___ Hollow rod ___ Jetted ___ Bored ___ Reverse rotary	
				8. Use: ___ Domestic ___ Public supply ___ Industry ___ Irrigation ___ Air conditioning ___ Stock ___ Lawn ___ Oil field water ___ Other	
5. Type and color of material		From To		9. Casing: Material _____ Height: Above or below Threaded _____ Welded _____ Surface _____ in. RMP _____ PVC _____ Weight _____ lbs./ft. Dia. _____ in. to _____ ft. depth Wall Thickness: inches or Dia. _____ in. to _____ ft. depth gage No. _____	
				10. Screen: Manufacturer's name _____ Type _____ Dia. _____ Slot/gauze _____ Length _____ Set between _____ ft. and _____ ft. _____ ft. and _____ ft. Gravel pack? _____ Size range of material _____	
Sand		265 270		11. Static water level: _____ mo./day/yr. _____ ft. below land surface Date _____	
Sandstone		270 278		12. Pumping level below land surfaces: _____ ft. after _____ hrs. pumping _____ g.p.m. _____ ft. after _____ hrs. pumping _____ g.p.m. Estimated maximum yield _____ g.p.m.	
Sand stone		278 284		13. Water sample submitted: _____ mo./day/yr. Yes No Date _____	
Sandstone		284 287		14. Well head completion: ___ Pitless adapter _____ inches above grade	
Sand		287 305		15. Well grouted? _____ With: ___ Neat cement ___ Bentonite ___ Concrete Depth: From _____ ft. to _____ ft.	
Gravel		305 309		16. Nearest source of possible contamination: ft. _____ Direction _____ Type _____ Well disinfected upon completion? Yes No	
Soapstone		309 317		17. Pump: _____ Not installed Manufacturer's name _____ Model number _____ HP _____ Volts _____ Length of drop pipe _____ ft. capacity _____ g.p.m. Type: ___ Submersible _____ Turbine ___ Jet _____ Reciprocating ___ Centrifugal _____ Other	
Shale		317 320		(Use a second sheet if needed)	
Depth		317			
Water		161		20. Water well contractor's certification: This well was drilled under my jurisdiction and this report is true to the best of my knowledge and belief. Business name _____ License No. _____ Address _____ Signed _____ Authorized representative _____ Date _____	
Gravel		66			
18. Elevation:		19. Remarks:			
Topography: ___ Hill ___ Slope ___ Upland ___ Valley					

T
 R
 Sec
 1/4 1/4 1/4 1/4
 6 42 16 NE NW SW