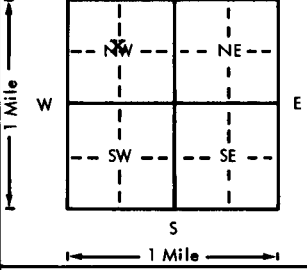


USE TYPEWRITER OR BALL POINT PEN—PRESS FIRMLY, PRINT CLEARLY.

WATER WELL RECORD
KSA 82a-1201-1215

Kansas Department of Health and Environment—Division of Environment
(Water well Contractors)
Topeka, Kansas 66620

BDB BDB

1. Location of well: County Sherman		Fraction SE NW 1/4 SW 1/4 NW 1/4		Section number 17	Township number T 6 S R 42	Range number 42	
2. Distance and direction from nearest town or city: From Kanorado; 13 3/4 North; 1/4 East Street address of well location if in city:				3. Owner of well: Boll, Merlyn R.R. or street: City, state, zip code: Kanorado, Kansas			
4. Locate with "X" in section below: 		Sketch map:		6. Bore hole dia. 36 in. Completion date 8-16-76 Well depth 278 ft.			
5. Type and color of material				From	To	7. <input type="checkbox"/> Cable tool <input type="checkbox"/> Rotary <input type="checkbox"/> Driven <input type="checkbox"/> Dug <input type="checkbox"/> Hollow rod <input type="checkbox"/> Jetted <input type="checkbox"/> Bored <input checked="" type="checkbox"/> Reverse rotary	
				Clay	0	65	8. Use: <input type="checkbox"/> Domestic <input type="checkbox"/> Public supply <input type="checkbox"/> Industry <input checked="" type="checkbox"/> Irrigation <input type="checkbox"/> Air conditioning <input type="checkbox"/> Stock <input type="checkbox"/> Lawn <input type="checkbox"/> Oil field water <input type="checkbox"/> Other
				Coarse Sand, Gravel, Clay	65	113	9. Casing: Material Steel Height: Above a 36 1/2 in. Threaded <input type="checkbox"/> Welded <input checked="" type="checkbox"/> Surface 12 in. RMP <input type="checkbox"/> PVC <input type="checkbox"/> Weight .188 lbs./ft. Dia 16 in. to 188 depth Wall Thickness: inches or Dia. <input type="checkbox"/> in. to <input type="checkbox"/> ft. depth gage No. #7
				Coarse Sand, Gravel	113	125	10. Screen: Manufacturer's name Brown Type REGULAR Dia. 16" Slot/gauze 10% Length 80' Set between 188 ft. and 268 ft. 10' Cook 268 ft. and 278 ft. Gravel pack? <input checked="" type="checkbox"/> Size range of material 5/8-3/16 #1
				Clay	125	130	11. Static water level: mo./day/yr. 167 ft. below land surface Date 9-17-76
				Coarse Sand, Gravel	130	137	12. Pumping level below land surfaces: ft. after hrs. pumping g.p.m. 276 ft. after 2 hrs. pumping 578 g.p.m. Estimated maximum yield 578 g.p.m.
				Clay, Sand Streaks	137	165	13. Water sample submitted: mo./day/yr. <input type="checkbox"/> Yes <input checked="" type="checkbox"/> No Date
				Sand, Gravel, Sand Stone	165	171	14. Well head completion: <input type="checkbox"/> Pitless adapter 12 inches above grade
				Clay	171	177	15. Well grouted? <input checked="" type="checkbox"/> With: <input type="checkbox"/> Neat cement <input checked="" type="checkbox"/> Bentonite <input checked="" type="checkbox"/> Concrete Clay Depth: From 0 ft. to 10 ft.
				Coarse Sand, Gravel	177	184	16. Nearest source of possible contamination: ft. 2000 Direction N Type House Well disinfected upon completion? <input type="checkbox"/> Yes <input checked="" type="checkbox"/> No
				Clay, Cemented	184	191	17. Pump: <input type="checkbox"/> Not installed Manufacturer's name Floway Model number 056178 HP 80 Volts 480 Length of drop pipe 265 ft. capacity g.p.m. Type: 12 Stage 10" DKM <input type="checkbox"/> Submersible <input checked="" type="checkbox"/> Turbine <input type="checkbox"/> Jet <input type="checkbox"/> Reciprocating <input type="checkbox"/> Centrifugal <input type="checkbox"/> Other
				Clay, Cemented, Sand Stone Streaks	191	210	20. Water well contractor's certification: This well was drilled under my jurisdiction and this report is true to the best of my knowledge and belief. Western Well & Pump 245 Business name License No. Address Box 852, Colby, KS 67701 Signed Dolly Berry Date 10-29-76 Authorized representative
				Med. Coarse Sand, Gravel, Sand Stone	210	230	
				Clay	230	232	
				Fine to Coarse Sand	232	261	18. Elevation: Topography: <input type="checkbox"/> Hill <input type="checkbox"/> Slope <input checked="" type="checkbox"/> Upland <input type="checkbox"/> Valley
Med. Coarse Sand, Small Gravel	261	273					
Ochre, Shale	BROCK 273 (Use a second sheet if needed)		19. Remarks: 3814 (TUPO)				
	273	278					

T 6 S R 42
1/4 SE NW NW