


WATER WELL RECORD Form WWC-5 KSA 82a-1212

1 LOCATION OF WATER WELL: County: SHEPHERD Fraction: SW 1/4 SE 1/4 NE 1/4 Section Number: 21 Township Number: T 6 S Range Number: R 42 EW

Distance and direction from nearest town or city street address of well if located within city?
KANORADO

2 WATER WELL OWNER: MERYLYN + SHIRLEY BOLL
RR#, St. Address, Box #: R1 Board of Agriculture, Division of Water Resources
City, State, ZIP Code: KANORADO KS 67741 Application Number: NONE

3 LOCATE WELL'S LOCATION WITH AN "X" IN SECTION BOX:

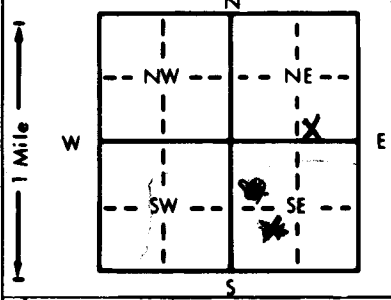

4 DEPTH OF COMPLETED WELL: 170 ft. ELEVATION: _____ ft.
Depth(s) Groundwater Encountered: 1. 168 ft. 2. _____ ft. 3. _____ ft.
WELL'S STATIC WATER LEVEL: 160 ft. below land surface measured on mo/day/yr NO WATER
Pump test data: Well water was _____ ft. after _____ hours pumping _____ gpm
Est. Yield _____ gpm: Well water was _____ ft. after _____ hours pumping _____ gpm
Bore Hole Diameter: _____ in. to _____ ft., and _____ in. to _____ ft.
WELL WATER TO BE USED AS:
 Domestic 3 Feedlot 6 Oil field water supply 9 Dewatering 12 Other (Specify below)
2 Irrigation 4 Industrial 7 Lawn and garden only 10 Observation well
Was a chemical/bacteriological sample submitted to Department? Yes _____ No _____; if yes, mo/day/yr sample was submitted _____
Water Well Disinfected? Yes _____ No _____

5 TYPE OF BLANK CASING USED:
1 Steel 3 RMP (SR) 5 Wrought iron 8 Concrete tile CASING JOINTS: Glued _____ Clamped _____
2 PVC 4 ABS 6 Asbestos-Cement 9 Other (specify below) Welded _____
Blank casing diameter: 5" in. to 170 ft., Dia _____ in. to _____ ft., Dia _____ in. to _____ ft.
Casing height above land surface _____ in., weight _____ lbs./ft. Wall thickness or gauge No. _____
TYPE OF SCREEN OR PERFORATION MATERIAL:
1 Steel 3 Stainless steel 5 Fiberglass 7 PVC 10 Asbestos-cement
2 Brass Galvanized steel 6 Concrete tile 8 RMP (SR) 11 Other (specify) _____
SCREEN OR PERFORATION OPENINGS ARE:
1 Continuous slot 3 Mill slot 5 Gauzed wrapped 8 Saw cut 11 None (open hole)
2 Louvered shutter 4 Key punched 6 Wire wrapped 9 Drilled holes
3 Torch cut 10 Other (specify) _____
SCREEN-PERFORATED INTERVALS: From _____ ft. to _____ ft., From _____ ft. to _____ ft.
GRAVEL PACK INTERVALS: From _____ ft. to _____ ft., From _____ ft. to _____ ft.

6 GROUT MATERIAL: 1 Neat cement 2 Cement grout 3 Bentonite 4 Other _____
Grout Intervals: From _____ ft. to _____ ft., From _____ ft. to _____ ft., From _____ ft. to _____ ft.
What is the nearest source of possible contamination:
1 Septic tank 4 Lateral lines 7 Pit privy 10 Livestock pens 14 Abandoned water well
2 Sewer lines 5 Cess pool 8 Sewage lagoon 11 Fuel storage 15 Oil well/Gas well
3 Watertight sewer lines 6 Seepage pit 9 Feedyard 12 Fertilizer storage 16 Other (specify below) _____
13 Insecticide storage _____
Direction from well? _____ How many feet? _____

FROM	TO	LITHOLOGIC LOG	FROM	TO	LITHOLOGIC LOG
		well was DRY AND CAVE IN			so we ABANDONED it
		Filled CLAY TO 3' FROM top			plug with CEMENT
		COVERED WITH SAND 3' BELOW SURFACE OF GROUND			
		AND			
3	0	CEMENT THEM COVER WITH			DIRT
170	3	CLAY			

7 CONTRACTOR'S OR LANDOWNER'S CERTIFICATION: This water well was (1) constructed, (2) reconstructed, or (3) plugged under my jurisdiction and was completed on (mo/day/year) MAY 15 1988 and this record is true to the best of my knowledge and belief. Kansas Water Well Contractor's License No. _____ This Water Well Record was completed on (mo/day/yr) _____ under the business name of _____ by (signature) Merylyn Boll

INSTRUCTIONS: Use typewriter or ball point pen. PLEASE PRESS FIRMLY and PRINT clearly. Please fill in blanks, underline or circle the correct answers. Send top three copies to Kansas Department of Health and Environment, Bureau of Water Protection, Topeka, Kansas 66620-7320, Telephone: 913-862-9360. Send one to WATER WELL OWNER and retain one for your records.