

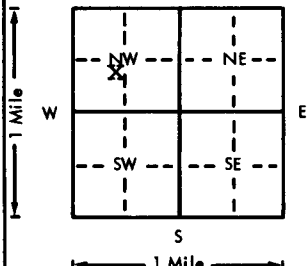
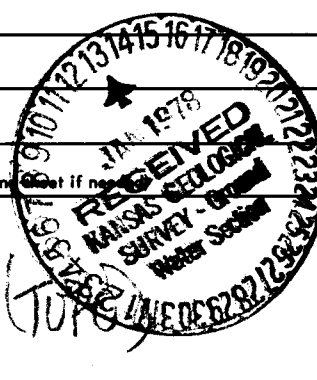
USE TYPEWRITER OR BALL
POINT PEN-PRESS FIRMLY,
PRINT CLEARLY.

WATER WELL RECORD
KSA 82a-1201-1215

Kansas Department of Health and
Environment-Division of Environment
(Water well Contractors)
Topeka, Kansas 66620

TWP: Grant

~~BCA~~ ADC

1. Location of well:		County Sherman	Fraction NW 1/4 SW 1/4	Section number 28	Township number T 6 S R 42	Range number 42
2. Distance and direction from nearest town or city: From Kanorado. North on Oil -12 mi. North; 2 mi. East; 1/2 mi. Street address of well location if in city: South			3. Owner of well: Merlyn Boll R.R. or street: City, state, zip code: Kanorado, Kansas			
4. Locate with "X" in section below: 			Sketch map: 6. Bore hole dia. 36 in. Completion date 5/6/76 Well depth 328 ft.			
5. Type and color of material			7. <input type="checkbox"/> Cable tool <input type="checkbox"/> Rotary <input type="checkbox"/> Driven <input type="checkbox"/> Dug <input type="checkbox"/> Hollow rod <input type="checkbox"/> Jetted <input type="checkbox"/> Bored <input checked="" type="checkbox"/> Reverse rotary			
			8. Use: <input checked="" type="checkbox"/> Domestic <input type="checkbox"/> Public supply <input type="checkbox"/> Industry <input checked="" type="checkbox"/> Irrigation <input type="checkbox"/> Air conditioning <input type="checkbox"/> Stock <input type="checkbox"/> Lawn <input type="checkbox"/> Oil field water <input type="checkbox"/> Other			
			9. Casing: Material Steel Height: Above XXXXX Threaded <input type="checkbox"/> Welded <input checked="" type="checkbox"/> Surface 12 in. RMP <input type="checkbox"/> PVC <input type="checkbox"/> Weight 168 lbs./ft. Dia. 16 in. to 238 ft. depth Wall Thickness: inches or Dia. <input type="checkbox"/> in. to <input type="checkbox"/> ft. depth gage No. #7			
			10. Screen: Manufacturer's name Brown Type Regular Dia. 16" Slot 10% Length 80 Set between 238 ft. and 318 ft. 10' Cook 318 ft. and 328 ft. Gravel pack? yes Size range of material 1/4 x 5/8			
			11. Static water level: <input type="checkbox"/> mo./day/yr. 189 ft. below land surface Date 5-10-76			
18. Elevation: Topography: <input type="checkbox"/> Hill <input type="checkbox"/> Slope <input checked="" type="checkbox"/> Upland <input type="checkbox"/> Valley			12. Pumping level below land surfaces: 310 ft. after 2 hrs. pumping 1016 g.p.m. <input type="checkbox"/> ft. after <input type="checkbox"/> hrs. pumping <input type="checkbox"/> g.p.m. Estimated maximum yield 1016 g.p.m.			
			13. Water sample submitted: <input type="checkbox"/> mo./day/yr. <input type="checkbox"/> Yes <input checked="" type="checkbox"/> No Date <input type="checkbox"/>			
			14. Well head completion: <input type="checkbox"/> Pitless adapter 12 inches above grade			
			15. Well grouted? yes <input type="checkbox"/> Clay With: <input type="checkbox"/> Neat cement <input type="checkbox"/> Bentonite XXX Depth: From 0 ft. to 10 ft.			
			16. Nearest source of possible contamination: ft. 3 mile Direction East Type House Well disinfected upon completion? <input type="checkbox"/> Yes <input checked="" type="checkbox"/> No			
19. Remarks: 3838 (TWP) 3842 BROOK 324' 			17. Pump: <input type="checkbox"/> Not installed Manufacturer's name Floway Model number 7650 HP 100 Volts <input type="checkbox"/> Length of drop pipe 310 ft. capacity 600 g.p.m. Type: 13 stage 10" D.O.H. Bowl <input type="checkbox"/> Submersible <input checked="" type="checkbox"/> Turbine <input type="checkbox"/> Jet <input type="checkbox"/> Reciprocating <input type="checkbox"/> Centrifugal <input type="checkbox"/> Other			
			20. Water well contractor's certification: This well was drilled under my jurisdiction and this report is true to the best of my knowledge and belief. Western Well & Pump, Inc. 245 Business name License No. Address P.O. Box 852 Colby, KS. Signed Darryl Berry Date 8-10-76 Authorized representative			