

USE TYPEWRITER OR BALL POINT PEN-PRESS FIRMLY, PRINT CLEARLY.

WATER WELL RECORD
KSA 82a-1201-1215


Kansas Department of Health and Environment-Division of Environment
(Water well Contractors)
Topeka, Kansas 66620

BEID

1. Location of well: County SHERMAN Fraction SE 1/4 NW 1/4 NW 1/4 Section number 33 Township number T 6 S R 42 NW

2. Distance and direction from nearest town or city: KANORADO
Street address of well location if in city: 2E 11N

3. Owner of well: W. H. DAISE
R.R. or street: 1401 Caldwell
City, state, zip code: Goodland KANSAS 67735

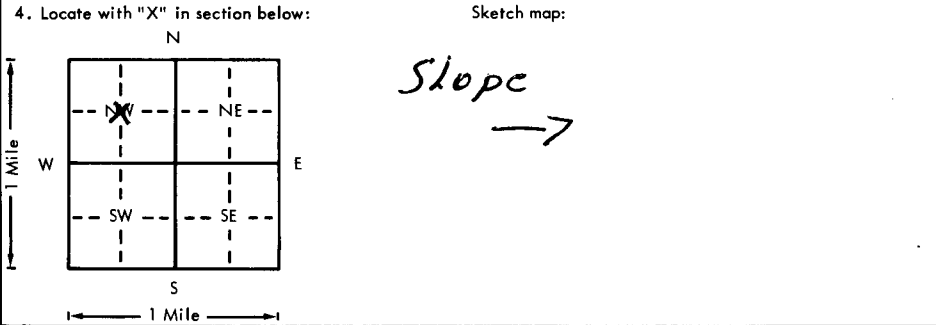

6. Bore hole dia. 8 in. Completion date 5-15-78
Well depth 332 ft.

7. Cable tool Rotary Driven Dug
 Hollow rod Jetted Bored Reverse rotary

8. Use: Domestic Public supply Industry
 Irrigation Air conditioning Stock
 Lawn Oil field water Other

9. Casing: Material Plastic Height: Above or below
Threaded Welded Surface 12 in.
RMP PVC Weight 18 lbs./ft.
Dia. 4 in. to 304 ft. depth Wall Thickness: inches or
Dia. 4 in. to 304 ft. depth gage No. 237

5. Type and color of material	From	To
<u>Top Soil</u>	<u>0</u>	<u>4</u>
<u>Clay, Sandstone</u>	<u>4</u>	<u>128</u>
<u>M Gravel</u>	<u>128</u>	<u>150</u>
<u>Sandy Clay</u>	<u>150</u>	<u>164</u>
<u>M Gravel</u>	<u>164</u>	<u>170</u>
<u>Fine Sand, Sandstone</u>	<u>170</u>	<u>229</u>
<u>Fine Sand, M Gravel</u>	<u>229</u>	<u>238</u>
<u>Sandy Clay, Sandstone</u>	<u>238</u>	<u>247</u>
<u>Fine Sand, Sandstone</u>	<u>247</u>	<u>273</u>
<u>Fine Sand, Sandy Clay</u>	<u>273</u>	<u>303</u>
<u>Fine Sand</u>	<u>303</u>	<u>314</u>
<u>Sandy Clay</u>	<u>314</u>	<u>317</u>
<u>Fine Sand, M Gravel</u> ?	<u>317</u>	<u>332</u>

10. Screen: Manufacturer's name Peerless
Type Lowyck Dia. 5"
Slot/gauze 1/8 x .258 Length 25'
Set between 304 ft. and 332 ft.
_____ ft. and _____ ft.
Gravel pack? YES Size range of material 1/8

11. Static water level: _____ mo./day/yr.
198 ft. below land surface Date 5-15-78

12. Pumping level below land surfaces:
230 ft. after 3 hrs. pumping 20 g.p.m.
_____ ft. after _____ hrs. pumping _____ g.p.m.
Estimated maximum yield 50 g.p.m.

13. Water sample submitted: _____ mo./day/yr.
Yes No Date _____

14. Well head completion: _____ Pitless adapter _____ Inches above grade _____

15. Well grouted? YES
With: Neat cement Bentonite Concrete
Depth: From 0 ft. to 10 ft.

16. Nearest source of possible contamination _____ ft. _____ Direction _____ Type PASTURE
Well disinfected upon completion? Yes No

17. Pump: Not installed
Manufacturer's name _____
Model number _____ HP _____ Volts _____
Length of drop pipe _____ ft. capacity _____ g.p.m.
Type: _____ Submersible _____ Turbine
_____ Jet _____ Reciprocating
_____ Centrifugal _____ Other

18. Elevation: _____

19. Remarks: 3868 (TOPO)

Topography:
 Hill
 Slope
 Upland
 Valley

20. Water well contractor's certification:
This well was drilled under my jurisdiction and this report is true to the best of my knowledge and belief.
Bill Clufford
Business name Bill Clufford License No. 166
Address Goodland Kansas
Signed Bill Clufford Date 5-19-78
Authorized representative 5-19-78

T-6
R-420
E-33
Sec-1/4 1/4 1/4
C-NW