


1 LOCATION OF WATER WELL: Fraction SE 1/4 SW 1/4 NE 1/4 Section Number 36 Township Number T 6 S Range Number R 42 E/W

Distance and direction from nearest town or city street address of well if located within city?
2 E, 10 N, 2 E, Kanorado

2 WATER WELL OWNER: Allen Kirby
 RR#, St. Address, Box #: HCR 3 Box 50 Board of Agriculture, Division of Water Resources
 City, State, ZIP Code: Goodland, KS 67735 Application Number:

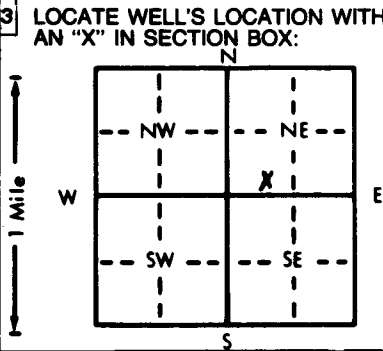

4 DEPTH OF COMPLETED WELL: 150 ft. ELEVATION:ft.
 Depth(s) Groundwater Encountered 1. 150 ft. 2.ft. 3.ft.
 WELL'S STATIC WATER LEVEL 999 ft. below land surface measured on mo/day/yrft.
 Pump test data: Well water wasft. after hours pumping gpm
 Est. Yield gpm: Well water wasft. after hours pumping gpm
 Bore Hole Diameterin. toft., andin. toft.
 WELL WATER TO BE USED AS:
 1 Domestic 3 Feedlot 6 Oil field water supply 9 Dewatering 12 Other (Specify below)
 2 Irrigation 4 Industrial 7 Lawn and garden only 10 Monitoring well
 Was a chemical/bacteriological sample submitted to Department? Yes.....No.....X.....; If yes, mo/day/yr sample was submitted
 Water Well Disinfected? Yes No X

5 TYPE OF BLANK CASING USED:
 1 Steel 3 RMP (SR) 5 Wrought iron 8 Concrete tile CASING JOINTS: Glued Clamped
 2 PVC 4 ABS 6 Asbestos-Cement 9 Other (specify below) Welded
 Blank casing diameter 4" in. toft., Diain. toft., Diain. toft.
 Casing height above land surface 48" in., weightlbs./ft. Wall thickness or gauge No.
 TYPE OF SCREEN OR PERFORATION MATERIAL:
 1 Steel 3 Stainless steel 5 Fiberglass 7 PVC 10 Asbestos-cement
 2 Brass 4 Galvanized steel 6 Concrete tile 8 RMP (SR) 11 Other (specify)
 3 None used (open hole)
 SCREEN OR PERFORATION OPENINGS ARE:
 1 Continuous slot 3 Mill slot 5 Gauzed wrapped 8 Saw cut 11 None (open hole)
 2 Louvered shutter 4 Key punched 6 Wire wrapped 9 Drilled holes
 7 Torch cut 10 Other (specify) NA
 SCREEN-PERFORATED INTERVALS: Fromft. toft., Fromft. toft.
 GRAVEL PACK INTERVALS: Fromft. toft., Fromft. toft.

6 GROUT MATERIAL: 1 Neat cement 2 Cement grout 3 Bentonite 4 Other
 Grout Intervals: From 6 ft. to 3 ft., Fromft. toft., Fromft. toft.
 What is the nearest source of possible contamination:
 1 Septic tank 4 Lateral lines 7 Pit privy 10 Livestock pens 14 Abandoned water well
 2 Sewer lines 5 Cess pool 8 Sewage lagoon 11 Fuel storage 15 Oil well/Gas well
 3 Watertight sewer lines 6 Seepage pit 9 Feedyard 12 Fertilizer storage 16 Other (specify below) DONE
 13 Insecticide storage
 Direction from well? How many feet?

FROM	TO	LITHOLOGIC LOG	FROM	TO	PLUGGING INTERVALS
		<i>Abandoned well</i>	<u>150</u>	<u>0</u>	Old well ripped off/with backhoe 8' deep.
			<u>11</u>	<u>8</u>	Back filled clay.
			<u>8</u>	<u>0</u>	Cement cap on casing.
					Location leveled.

7 CONTRACTOR'S OR LANDOWNER'S CERTIFICATION: This water well was (1) constructed, (2) reconstructed, or (3) plugged under my jurisdiction and was completed on (mo/day/year) 6-18-91 and this record is true to the best of my knowledge and belief. Kansas Water Well Contractor's License No. 484 This Water Well Record was completed on (mo/day/yr) 6-18-91 under the business name of Schaal Drilling, Co. by (signature) *Ruben Schaal*