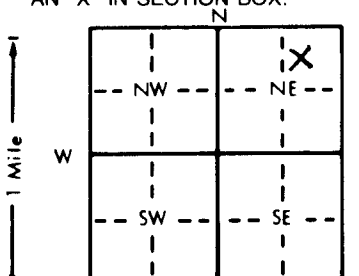


1 LOCATION OF WATER WELL: Fraction SE-NW 1/4 NE 1/4 NE 1/4 Section Number 36 Township Number T 6 S Range Number R 8 EW

Distance and direction from nearest town or city street address of well if located within city?
1 mile west, 1 mile north of Beloit, Kansas

2 WATER WELL OWNER: Mitchell Co. Landfill-Highway Dept. Board of Agriculture, Division of Water Resources
 RR#, St. Address, Box #: Box 8 Application Number:
 City, State, ZIP Code: Beloit, Ks. 67420

3 LOCATE WELL'S LOCATION WITH AN "X" IN SECTION BOX:  4 DEPTH OF COMPLETED WELL: 162 ft. ELEVATION:
 WELL WATER TO BE USED AS: 5 Public water supply 8 Air conditioning 11 Injection well
 1 Domestic 3 Feedlot 6 Oil field water supply 9 Dewatering 12 Other (Specify below)
 2 Irrigation 4 Industrial 7 Lawn and garden only 10 Monitoring well
 Was a chemical/bacteriological sample submitted to Department? Yes X No ; If yes, mo/day/yr sample was submitted
 Water Well Disinfected? Yes X No

5 TYPE OF BLANK CASING USED: 1 Steel 2 PVC 3 RMP (SR) 4 ABS 5 Wrought iron 6 Asbestos-Cement 7 Fiberglass 8 Concrete tile 9 Other (specify below) CASING JOINTS: Glued Clamped Welded Threaded SS Screws
 TYPE OF SCREEN OR PERFORATION MATERIAL: 1 Steel 2 Brass 3 Stainless steel 4 Galvanized steel 5 Fiberglass 6 Concrete tile 7 PVC 8 RMP (SR) 9 ABS 10 Asbestos-cement 11 Other (specify) 12 None used (open hole)
 SCREEN OR PERFORATION OPENINGS ARE: 1 Continuous slot 2 Louvered shutter 3 Mill slot 4 Key punched 5 Gauzed wrapped 6 Wire wrapped 7 Torch cut 8 Saw cut 9 Drilled holes 11 None (open hole)

6 GROUT MATERIAL: 1 Neat cement 2 Cement grout 3 Bentonite 4 Other
 What is the nearest source of possible contamination: 1 Septic tank 2 Sewer lines 3 Watertight sewer lines 4 Lateral lines 5 Cess pool 6 Seepage pit 7 Pit privy 8 Sewage lagoon 9 Feedyard 10 Livestock pens 11 Fuel storage 12 Fertilizer storage 13 Insecticide storage 14 Abandoned water well 15 Oil well/Gas well 16 Other (specify below) On Sanitary Landfill

Direction from well? How many feet?

FROM	TO	LITHOLOGIC LOG	FROM	TO	PLUGGING INTERVALS
0	2	Top Soil	27	27.5	Limestone
2	5	Weathered Shale	27.5	28	Grey Shale & Layers
5	6	Limestone	28	28.5	Hard Limestone
6	9	Weathered Shale	28.5	30	Limestone Layers & Shale
9	9.2	Limestone Layer	30	33	Hard Shale
9.2	10	Weathered Shale	33	33.2	Limestone, light grey
10	10.5	Limestone	33.2	35.2	Limestone
10.5	11	Grey Shale	35.2	38.4	Hard Limestone
11	11.5	Hard Layer	38.4	49	Shale light grey
11.5	13	Grey Shale	49	49.6	Limestone
13	13.5	Hard Grey limestone	49.6	53	Grey Shale
13.5	22	Hard Gr shale & limestone lyrs	53	56.5	Limestone & Shale Layers
22	26	Hard Grey Shale	56.5	57	Limestone, grey to white
26	26.25	Grey limestone	57	64	Light Grey Shale
26.25	27	Shale	64	64.6	Limestone

7 CONTRACTOR'S OR LANDOWNER'S CERTIFICATION: This water well was (1) constructed, (2) reconstructed, or (3) plugged under my jurisdiction and was completed on (mo/day/year) and this record is true to the best of my knowledge and belief. Kansas Water Well Contractor's License No. This Water Well Record was completed on (mo/day/yr) under the business name of by (signature)


INSTRUCTIONS: Use typewriter or ball point pen. PLEASE PRESS FIRMLY and PRINT clearly. Please fill in blanks, underline or circle the correct answers. Send top three copies to Kansas Department of Health and Environment, Bureau of Water, Topeka, Kansas 66620-0001. Telephone: 913-296-5545. Send one to WATER WELL OWNER and retain one for your records.

OFFICE USE ONLY
T
R
EW
SEC
1/4
1/4
1/4

1 LOCATION OF WATER WELL: Fraction NW 1/4 NE 1/4 NE 1/4 Section Number 36 Township Number T 6 S Range Number R 8 E (W)
 County: Mitchell

Distance and direction from nearest town or city street address of well if located within city?

2 WATER WELL OWNER: Mitchell Co. Landfill (cont.) Board of Agriculture, Division of Water Resources
 RR#, St. Address, Box # : Application Number:
 City, State, ZIP Code :

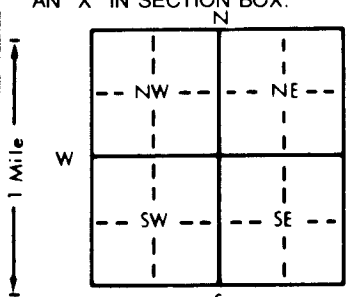3 LOCATE WELL'S LOCATION WITH AN "X" IN SECTION BOX:  DEPTH OF COMPLETED WELL: ft. ELEVATION: ft.
 Depth(s) Groundwater Encountered 1. ft. 2. ft. 3. ft.
 WELL'S STATIC WATER LEVEL ft. below land surface measured on mo/day/yr
 Pump test data: Well water was ft. after hours pumping gpm
 Est. Yield gpm: Well water was ft. after hours pumping gpm
 Bore Hole Diameter in. to ft., and in. to ft.
 WELL WATER TO BE USED AS: 5 Public water supply 8 Air conditioning 11 Injection well
 1 Domestic 3 Feedlot 6 Oil field water supply 9 Dewatering 12 Other (Specify below)
 2 Irrigation 4 Industrial 7 Lawn and garden only 10 Monitoring well
 Was a chemical/bacteriological sample submitted to Department? Yes.....No.....; If yes, mo/day/yr sample was submitted
 Water Well Disinfected? Yes No

5 TYPE OF BLANK CASING USED: 5 Wrought iron 8 Concrete tile CASING JOINTS: Glued Clamped
 1 Steel 3 RMP (SR) 6 Asbestos-Cement 9 Other (specify below) Welded
 2 PVC 4 ABS 7 Fiberglass Threaded.....
 Blank casing diameter in. to ft., Dia in. to ft., Dia in. to ft.
 Casing height above land surface in., weight lbs./ft. Wall thickness or gauge No.
 TYPE OF SCREEN OR PERFORATION MATERIAL: 7 PVC 10 Asbestos-cement
 1 Steel 3 Stainless steel 5 Fiberglass 8 RMP (SR) 11 Other (specify)
 2 Brass 4 Galvanized steel 6 Concrete tile 9 ABS 12 None used (open hole)
 SCREEN OR PERFORATION OPENINGS ARE: 5 Gauzed wrapped 8 Saw cut 11 None (open hole)
 1 Continuous slot 3 Mill slot 6 Wire wrapped 9 Drilled holes
 2 Louvered shutter 4 Key punched 7 Torch cut 10 Other (specify)
 SCREEN-PERFORATED INTERVALS: From ft. to ft., From ft. to ft.
 From ft. to ft., From ft. to ft.
 GRAVEL PACK INTERVALS: From ft. to ft., From ft. to ft.
 From ft. to ft., From ft. to ft.

6 GROUT MATERIAL: 1 Neat cement 2 Cement grout 3 Bentonite 4 Other
 Grout Intervals: From ft. to ft., From ft. to ft.
 What is the nearest source of possible contamination:
 1 Septic tank 4 Lateral lines 7 Pit privy 10 Livestock pens 14 Abandoned water well
 2 Sewer lines 5 Cess pool 8 Sewage lagoon 11 Fuel storage 15 Oil well/Gas well
 3 Watertight sewer lines 6 Seepage pit 9 Feedyard 12 Fertilizer storage 16 Other (specify below)
 13 Insecticide storage
 Direction from well? How many feet?

FROM	TO	LITHOLOGIC LOG	FROM	TO	PLUGGING INTERVALS
64.6	82	Med. gray shale	128.6	140.2	Silt
82	86	Shale	140.2	140.3	Limestone
86	86.1	Limestone	140.3	142	Silt
86.1	97.1	Shale, Med. gray	142	143	Hard Layer
97.1	97.4	Hard Limestone	143	145.5	Shale
97.4	98.4	Shale	145.5	146	Hard Limestone Layer
98.4	98.5	Hard Limestone	146	162	Shale
98.5	102	Med. Gray shale			
102	108	Med. Gray shale			
108	110	Hard Limestone			
110	113.8	Med. Gray shale			
113.8	113.9	Limestone			
113.9	122	Med. Gray shale w/limestone strks.			
122	128	Med. Gray Shale			
128	128.6	Limestone			

7 CONTRACTOR'S OR LANDOWNER'S CERTIFICATION: This water well was (1) constructed, (2) reconstructed, or (3) plugged under my jurisdiction and was completed on (mo/day/year) 12-19-92 and this record is true to the best of my knowledge and belief. Kansas Water Well Contractor's License No. 554 This Water Well Record was completed on (mo/day/yr) 12-22-92 under the business name of WOOFTER PUMP & Well, Inc. by (signature) Jay C. Woofter

OFFICE USE ONLY
T
R
EW
SEC
1/4
1/4
1/4