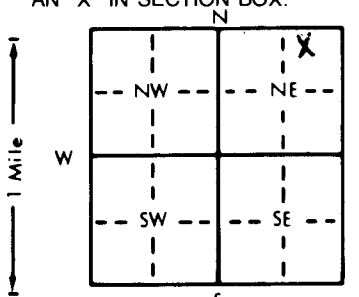


1 LOCATION OF WATER WELL: Fraction NE-NW 1/4 NE 1/4 NE 1/4 Section Number 36 Township Number T 6 S Range Number R 8 E/W
 County: Mitchell

Distance and direction from nearest town or city street address of well if located within city?
1 mile west, 1 mile north, of Beloit, Kansas

2 WATER WELL OWNER: Mitchell county Landfill-Highway Dept.
 RR#, St. Address, Box #: Box 8 Board of Agriculture, Division of Water Resources
 City, State, ZIP Code: Beloit, Ks. 67420 Application Number:

3 LOCATE WELL'S LOCATION WITH AN "X" IN SECTION BOX:  DEPTH OF COMPLETED WELL: 19 ft. ELEVATION:
 Depth(s) Groundwater Encountered 1. ft. 2. ft. 3. ft.
 WELL'S STATIC WATER LEVEL 8.43 ft. below land surface measured on mo/day/yr
 Pump test data: Well water was ft. after hours pumping gpm
 Est. Yield gpm: Well water was ft. after hours pumping gpm
 Bore Hole Diameter: 12 in. to 19 in. to in. to in. to ft.
 WELL WATER TO BE USED AS: 5 Public water supply 8 Air conditioning 11 Injection well
 1 Domestic 3 Feedlot 6 Oil field water supply 9 Dewatering 12 Other (Specify below)
 2 Irrigation 4 Industrial 7 Lawn and garden only 10 Monitoring well
 Was a chemical/bacteriological sample submitted to Department? Yes X No; If yes, mo/day/yr sample was submitted
 Water Well Disinfected? Yes X No

5 TYPE OF BLANK CASING USED: 5 Wrought iron 8 Concrete tile CASING JOINTS: Glued Clamped
 1 Steel 3 RMP (SR) 6 Asbestos-Cement 9 Other (specify below) Welded
 2 PVC 4 ABS 7 Fiberglass Threaded SS Screws
 Blank casing diameter 5 in. to 12.3 ft. Dia. in. to ft. Dia. in. to ft.
 Casing height above land surface: 6' in. weight 2.355 lbs./ft. Wall thickness or gauge No. 214
 TYPE OF SCREEN OR PERFORATION MATERIAL: 7 PVC 10 Asbestos-cement
 1 Steel 3 Stainless steel 5 Fiberglass 8 RMP (SR) 11 Other (specify)
 2 Brass 4 Galvanized steel 6 Concrete tile 9 ABS 12 None used (open hole)
 SCREEN OR PERFORATION OPENINGS ARE: 5 Gauzed wrapped 8 Saw cut 11 None (open hole)
 1 Continuous slot 3 Mill slot 6 Wire wrapped 9 Drilled holes
 2 Louvered shutter 4 Key punched 7 Torch cut 10 Other (specify)
 SCREEN-PERFORATED INTERVALS: From 12.3 ft. to 19 ft. From ft. to ft.
 From ft. to ft. From ft. to ft.
 GRAVEL PACK INTERVALS: From 9 ft. to 19 ft. From ft. to ft.
 From ft. to ft. From ft. to ft.

6 GROUT MATERIAL: 1 Neat cement 2 Cement grout 3 Bentonite 4 Other
 Grout Intervals: From 9 ft. to 0 ft. From ft. to ft. From ft. to ft.
 What is the nearest source of possible contamination:
 1 Septic tank 4 Lateral lines 7 Pit privy 10 Livestock pens 14 Abandoned water well
 2 Sewer lines 5 Cess pool 8 Sewage lagoon 11 Fuel storage 15 Oil well/Gas well
 3 Watertight sewer lines 6 Seepage pit 9 Feedyard 12 Fertilizer storage 16 Other (specify below)
 13 Insecticide storage On Sanitary Landfill
 Direction from well? How many feet?

FROM	TO	LITHOLOGIC LOG	FROM	TO	PLUGGING INTERVALS
0	5	Topsoil, drk brn.			
5	5.3	Ls, yel-tan, soft			
5.3	6	Shale, weathered, silty			
6	6.3	Ls. tan			
6.3	7.2	Shale, yel-tan firm			
7.2	7.8	Ls. yel-tan			
7.8	9.5	Shale, yel-tan, chalky			
9.5	10	Ls, yel-orange, very hard			
10	13	Shale, tan-gray			
13	13.8	Ls, yellow			
13.8	17	Shale, brn-gray, firm			
17	17.3	Ls, hard, white			
17.3	19	Shale, gray			

7 CONTRACTOR'S OR LANDOWNER'S CERTIFICATION: This water well was (1) constructed, (2) reconstructed, or (3) plugged under my jurisdiction and was completed on (mo/day/year) 12-18-92 and this record is true to the best of my knowledge and belief. Kansas Water Well Contractor's License No. 554 This Water Well Record was completed on (mo/day/yr) 1-5-93 under the business name of WOOFER PUMP & WELL, INC. by (signature) Jay C. [Signature]

OFFICE USE ONLY
T
R
EW
SEC
1/4
1/4
1/4