


1 LOCATION OF WATER WELL: Fraction NE 1/4 NE 1/4 SE 1/4 Section Number 35 Township Number 6 Range Number 9 E/W E
 County: Mitchell

Distance and direction from nearest town or city street address of well if located within city?
Approximately 1 mile East and 1 mile South of Glen Elder

2 WATER WELL OWNER: City of Glen Elder
213 S. Market Box 55
 RR #, St. Address, Box #: Glen Elder, KS 67446 Board of Agriculture, Division of Water Resources
 City, State, ZIP Code : Glen Elder, KS 67446 Application Number:

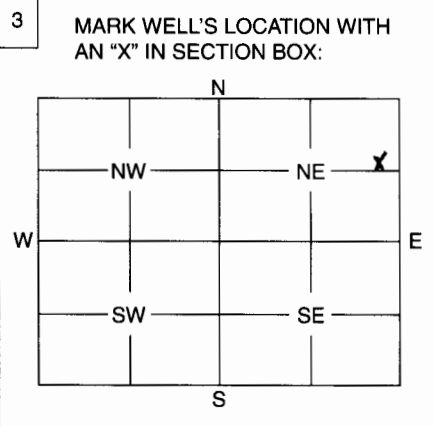

4 DEPTH OF WELL 50 ft.
 WELL'S STATIC WATER LEVEL 14 ft.
 WELL WAS USED AS:
 1 Domestic 2 Irrigation 3 Feedlot 4 Industrial 5 Public Water Supply 6 Oil Field Water Supply 7 Domestic (Lawn & Garden) 8 Air Conditioning 9 Dewatering 10 Monitoring Well 11 Injection Well 12 Other
 Was a chemical / bacteriological sample submitted to Department? Yes No
 If yes, mo/day/yr sample was submitted
 Water Well Disinfected: Yes No

5 TYPE OF BLANK CASING USED:
 1 Steel 2 PVC 3 RMP (SR) 4 ABS 5 Wrought 6 Asbestos-Cement 7 Fiberglass 8 Concrete Tile 9 Other (Specify below)
 Blank casing diameter in. Was casing pulled? Yes No If yes, how much
 Casing height above or below land surface 24 in.

6 GROUT PLUG MATERIAL: 1 Neat cement 2 Cement grout 3 Bentonite 4 Other Bentonite Hole Plug
 Grout Plug Intervals: From ft. to ft., From ft. to ft., From 50 to 0 ft.
 What is the nearest source of possible contamination:
 1 Septic tank 2 Sewer lines 3 Watertight sewer lines 4 Lateral lines 5 Cess pool 6 Seepage pit 7 Pit privy 8 Sewage lagoon 9 Feedyard 10 Livestock pens 11 Fuel storage 12 Fertilizer storage 13 Insecticide storage 14 Abandoned water well 15 Oil well/Gas well 16 Other (specify below) None Known
 Direction from well? How many feet?

FROM	TO	PLUGGING MATERIALS

7 CONTRACTOR'S OR LANDOWNER'S CERTIFICATION: This water well was plugged under my jurisdiction and was completed on (mo/day/year) 5-15-07 and this record is true to the best of my knowledge and belief. Kansas Water Well Contractor's License No. 12-6-07 This Water Well Record was completed on (mo/day/year) 12-6-07 under the business name of by (signature) Alvin Bohner

INSTRUCTIONS: Use typewriter or ball point pen. Please press firmly and print clearly. Please fill in blanks, underline or circle the correct answers. Send top three copies to Kansas Department of Health and Environment, Bureau of Water, Geology Section, 1000 SW Jackson St., Ste. 420, Topeka, Kansas 66612-1367. Telephone: 785/296-5522. Send one to Water Well Owner and retain one for your records.