


1 LOCATION OF WATER WELL: Fraction NW 1/4 SE 1/4 SE 1/4 Section Number 27 Township Number T 6 S Range Number R 9 E/W

Distance and direction from nearest town or city street address of well if located within city? 201 Hobart Street, Glen Elder

2 WATER WELL OWNER: Farmway Coop, Inc. RR#, St. Address, Box #: P.O. Box 568 City, State, ZIP Code: Beloit, Kansas 67420 Board of Agriculture, Division of Water Resources Application Number:

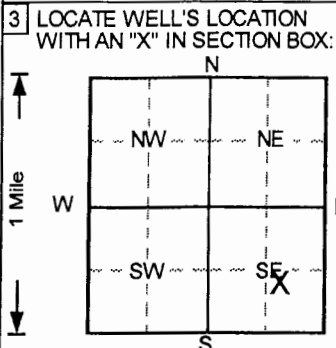

3 LOCATE WELL'S LOCATION WITH AN "X" IN SECTION BOX: 4 DEPTH OF COMPLETED WELL . . . . 42 . . . . ft. ELEVATION: . . . . 1424.28. WELL'S STATIC WATER LEVEL . . . 32.12 . . . ft. below land surface measured on mo/day/yr . . . 7/16/2010.

5 TYPE OF BLANK CASING USED: 1 Steel, 2 PVC, 3 RMP (SR), 4 ABS, 5 Wrought iron, 6 Asbestos-Cement, 7 Fiberglass, 8 Concrete tile, 9 Other (specify below). CASING JOINTS: Glued, Clamped, Welded, Threaded. SCREEN OR PERFORATION MATERIAL: 1 Steel, 2 Brass, 3 Stainless steel, 4 Galvanized steel, 5 Fiberglass, 6 Concrete tile, 7 PVC, 8 RMP (SR), 9 ABS, 10 Asbestos-cement, 11 Other (specify), 12 None used (open hole).

6 GROUT MATERIAL: 1 Neat cement, 2 Cement grout, 3 Bentonite, 4 Other. Grout intervals: From . . . . 0 . . . . ft to . . . . 1 . . . . ft, From . . . . 1 . . . . ft to . . . . 24 . . . . ft. What is the nearest source of possible contamination: 1 Septic tank, 2 Sewer lines, 3 Watertight sewer lines, 4 Lateral lines, 5 Cess pool, 6 Seepage pit, 7 Pit privy, 8 Sewage lagoon, 9 Feedyard, 10 Livestock pens, 11 Fuel storage, 12 Fertilizer storage, 13 Insecticide storage, 14 Abandoned water well, 15 Oil well/Gas well, 16 Other (specify below).

Table with columns: FROM, TO, LITHOLOGIC LOG, FROM, TO, PLUGGING INTERVALS. Rows describe geological layers from 0 to 42 feet depth, including Gravel, clay, Clay, silty, sandy, Brown, Silt, Lt. To Med. Gray Brown, Clay, silty, Brown, Clay, silty, occ. LS clasts, Brown, Clay, v. silty, plastic, Lt. Brown, Clay, silty, abnt LS gravel, Lt. Brown, Clay, w/f-m gravel and f-c sand, Lt. Brown, Sand and gravel, f-c sand w/f-m gravel. Includes MW4, Tag # 0045428, Flushmount.

7 CONTRACTOR'S OR LANDOWNER'S CERTIFICATION: This water well was (1) constructed, (2) reconstructed, or (3) plugged under my jurisdiction and was completed on (mo/day/year) . . . . 6/24/2010 . . . . and this record is true to the best of my knowledge and belief. Kansas Water Well Contractor's License No. . . . . 527 . . . . This Water Well Record was completed on (mo/day/yr) . . . . 7/16/2010 . . . . under the business name of . . . . GeoCore, Inc. . . . . by (signature) . . . .