


1 LOCATION OF WATER WELL: County: <b>Mitchell</b>	Fraction <b>NW ¼ SE ¼ SE ¼</b>	Section Number <b>27</b>	Township Number <b>T 6 S</b>	Range Number <b>R 9 E/W</b>
--	-----------------------------------	-----------------------------	---------------------------------	--------------------------------

Distance and direction from nearest town or city street address of well if located within city?  
**201 Hobart Street, Glen Elder**

2 WATER WELL OWNER: **Farmway Coop, Inc.**  
 RR#, St Address, Box # : **P.O. Box 568**  
 City, State, ZIP Code : **Beloit, Kansas 67420**  
 Board of Agriculture, Division of Water Resources  
 Application Number:

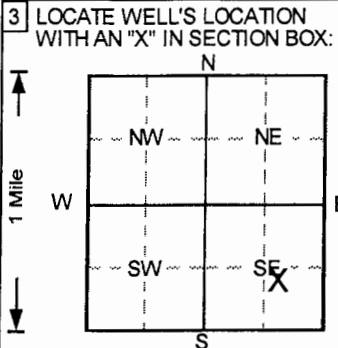

4 DEPTH OF COMPLETED WELL: **42** ft ELEVATION: **1423.55**  
 Depth(s) Groundwater Encountered 1. \_\_\_\_\_ ft 2. \_\_\_\_\_ ft 3. \_\_\_\_\_ ft  
 WELL'S STATIC WATER LEVEL: **31.63** ft below land surface measured on mo/day/yr: **7/16/2010**  
 Pump test data: Well water was **NA** ft after \_\_\_\_\_ hours pumping \_\_\_\_\_ gpm  
 Est. Yield: **NA** gpm: Well water was \_\_\_\_\_ ft after \_\_\_\_\_ hours pumping \_\_\_\_\_ gpm  
 Bore Hole Diameter: **8** in. to **42** ft, and \_\_\_\_\_ in. to \_\_\_\_\_ ft  
 WELL WATER TO BE USED AS:  
 5 Public water supply 8 Air conditioning 11 Injection well  
 1 Domestic 3 Feedlot 6 Oil field water supply 9 Dewatering 12 Other (Specify below)  
 2 Irrigation 4 Industrial 7 Lawn and garden only **10** Monitoring well  
 Was a chemical/bacteriological sample submitted to Department? Yes \_\_\_\_\_ No   
 Water Well Disinfected? Yes \_\_\_\_\_ No

5 TYPE OF BLANK CASING USED:  
 1 Steel 3 RMP (SR) 5 Wrought iron 8 Concrete tile  
**2** PVC 4 ABS 6 Asbestos-Cement 9 Other (specify below)  
 7 Fiberglass  
 Blank casing diameter: **2** in. to **27** ft, Dia \_\_\_\_\_ in. to \_\_\_\_\_ ft, Dia \_\_\_\_\_ in. to \_\_\_\_\_ ft  
 Casing height above land surface: **-5.88** in., weight \_\_\_\_\_ lbs./ft. Wall thickness or gauge No. **Sch. 40**  
 TYPE OF SCREEN OR PERFORATION MATERIAL:  
 1 Steel 3 Stainless steel 5 Fiberglass **7** PVC 10 Asbestos-cement  
 2 Brass 4 Galvanized steel 6 Concrete tile 8 RMP (SR) 11 Other (specify) \_\_\_\_\_  
 12 None used (open hole)  
 SCREEN OR PERFORATION OPENINGS ARE:  
 1 Continuous slot **3** Mill slot 5 Gauzed wrapped 8 Saw cut 11 None (open hole)  
 2 Louvered shutter 4 Key punched 6 Wire wrapped 9 Drilled holes  
 7 Torch cut 10 Other (specify) \_\_\_\_\_  
 SCREEN-PERFORATED INTERVALS: From **27** ft to **42** ft, From \_\_\_\_\_ ft to \_\_\_\_\_ ft  
 From \_\_\_\_\_ ft to \_\_\_\_\_ ft, From \_\_\_\_\_ ft to \_\_\_\_\_ ft  
 GRAVEL PACK INTERVALS: From **25** ft to **42** ft, From \_\_\_\_\_ ft to \_\_\_\_\_ ft  
 From \_\_\_\_\_ ft to \_\_\_\_\_ ft, From \_\_\_\_\_ ft to \_\_\_\_\_ ft

6 GROUT MATERIAL: 1 Neat cement **2** Cement grout **3** Bentonite 4 Other \_\_\_\_\_  
 Grout Intervals: From **0** ft to **1** ft, From **1** ft to **25** ft, From \_\_\_\_\_ ft to \_\_\_\_\_ ft  
 What is the nearest source of possible contamination:  
 1 Septic tank 4 Lateral lines 7 Pit privy 10 Livestock pens 14 Abandoned water well  
 2 Sewer lines 5 Cess pool 8 Sewage lagoon 11 Fuel storage 15 Oil well/Gas well  
 3 Watertight sewer lines 6 Seepage pit 9 Feedyard 12 Fertilizer storage 16 Other (specify below) \_\_\_\_\_  
 13 Insecticide storage \_\_\_\_\_  
 Direction from well? \_\_\_\_\_ How many feet? \_\_\_\_\_

FROM	TO	LITHOLOGIC LOG	FROM	TO	PLUGGING INTERVALS
0	4	Clay, silty, Brown			
4	17	Clay, sl. silty, Brown			
17	21	Clay, stiff, Brown to Yellow Brown			
21	26	Clay, sl. silty, Yellow Brown			
26	31	Clay, w/abnt white calc. mat., plastic, Yellow			
31	34	Sand and gravel, f-c sand w/f gravel, Yellow			
34	37	Gravel, f-m w/f-c sand, clayey in part, Yellow			
37	42	Gravel, f-m w/f-c sand, Yellow to Yellow Brow			
					MW10, Tag # 0042452, Flushmount

7 CONTRACTOR'S OR LANDOWNER'S CERTIFICATION: This water well was **(1)** constructed, (2) reconstructed, or (3) plugged under my jurisdiction and was completed on (mo/day/year) **7/12/2010** and this record is true to the best of my knowledge and belief.  
 Kansas Water Well Contractor's License No. **527** This Water Well Record was completed on (mo/day/yr) **7/16/2010**  
 under the business name of **GeoCore, Inc.** by (signature) *Dale Bell*

INSTRUCTIONS: Use typewriter or ball point pen. PLEASE PRESS FIRMLY and PRINT clearly. Please fill in blanks, underline or circle the correct answers. Send top three copies to Kansas Department of Health and Environment, Bureau of Water, Topeka, Kansas 66620-0001. Telephone: 913-296-5545. Send one to WATER WELL OWNER and retain one for your records.