


1 LOCATION OF WATER WELL: County: Mitchell	Fraction NE ¼ SW ¼ SE ¼	Section Number 27	Township Number T 6 S	Range Number R 9 E/W
--	-----------------------------------	-----------------------------	---------------------------------	--------------------------------

Distance and direction from nearest town or city street address of well if located within city?
201 Hobart Street, Glen Elder

2 WATER WELL OWNER: **Farmway Coop, Inc.**
 RR#, St. Address, Box # : **P.O. Box 568**
 City, State, ZIP Code : **Beloit, Kansas 67420**
 Board of Agriculture, Division of Water Resources
 Application Number:

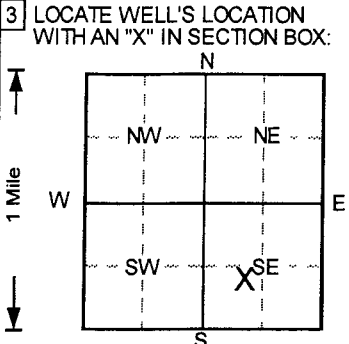

4 DEPTH OF COMPLETED WELL **45** ft ELEVATION: **1424.8**

Depth(s) Groundwater Encountered 1. ft 2. ft 3. ft

WELL'S STATIC WATER LEVEL . . . **32.55** . . . ft. below land surface measured on mo/day/yr . . . **7/16/2010**

Pump test data: Well water was . . . **NA** . . . ft. after hours pumping gpm

Est. Yield . . **NA** . . gpm: Well water was ft. after hours pumping gpm

Bore Hole Diameter **8** . . . in. to **45** ft., and in. to ft.

WELL WATER TO BE USED AS: 5 Public water supply 8 Air conditioning 11 Injection well
 1 Domestic 3 Feedlot 6 Oil field water supply 9 Dewatering 12 Other (Specify below)
 2 Irrigation 4 Industrial 7 Lawn and garden only **10** Monitoring well

Was a chemical/bacteriological sample submitted to Department? Yes.....No ; If yes, mo/day/yr sample was submitted

Water Well Disinfected? Yes No

5 TYPE OF BLANK CASING USED: 5 Wrought iron 8 Concrete tile CASING JOINTS: Glued Clamped
 1 Steel 3 RMP (SR) 6 Asbestos-Cement 9 Other (specify below) Welded
2 PVC 4 ABS 7 Fiberglass Threaded.

Blank casing diameter **2** in. to **30** ft, Dia in. to ft, Dia in. to ft.

Casing height above land surface **3.84** in., weight lbs./ft. Wall thickness or gauge No. **Sch. 40**

TYPE OF SCREEN OR PERFORATION MATERIAL **7** PVC 10 Asbestos-cement
 1 Steel 3 Stainless steel 5 Fiberglass **8** RMP (SR) 11 Other (specify)
 2 Brass 4 Galvanized steel 6 Concrete tile 9 ABS 12 None used (open hole)

SCREEN OR PERFORATION OPENINGS ARE: 5 Gauzed wrapped 8 Saw cut 11 None (open hole)
 1 Continuous slot **3** Mill slot 6 Wire wrapped 9 Drilled holes
 2 Louvered shutter 4 Key punched 7 Torch cut 10 Other (specify)

SCREEN-PERFORATED INTERVALS: From **30** ft to **45** ft, From ft to ft
 From ft to ft, From ft to ft

GRAVEL PACK INTERVALS: From **27** ft to **45** ft, From ft to ft
 From ft to ft, From ft to ft

6 GROUT MATERIAL: 1 Neat cement **2** Cement grout **3** Bentonite 4 Other
 Grout Intervals: From **0** ft to **1** ft, From **1** ft to **27** ft, From ft to ft

What is the nearest source of possible contamination:
 1 Septic tank 4 Lateral lines 7 Pit privy 10 Livestock pens 14 Abandoned water well
 2 Sewer lines 5 Cess pool 8 Sewage lagoon 11 Fuel storage 15 Oil well/Gas well
 3 Watertight sewer lines 6 Seepage pit 9 Feedyard 12 Fertilizer storage 16 Other (specify below)
 13 Insecticide storage

Direction from well? How many feet?

FROM	TO	LITHOLOGIC LOG	FROM	TO	PLUGGING INTERVALS
0	0.5	Concrete,			
0.5	2	Clay, silty, Brown to Dark Brown			
2	9	Silt, sl. clayey, Brown to Lt. Brown			
9	20	Clay, silty, Brown			
20	24	Clay, v. silty, plastic, Brown			
24	35	Clay, silty, plastic, Brown			
35	39	Clay, v. silty, Yellow Brown			
39	41	Clay, w/LS gravel (f-m) tr. sand, Brown to Ye			
41	45	Sand, f-c w/gravel, Brown			
					MW2, Tag # 0045429, Flushmount

7 CONTRACTOR'S OR LANDOWNER'S CERTIFICATION: This water well was **(1)** constructed, (2) reconstructed, or (3) plugged under my jurisdiction and was completed on (mo/day/year) **6/23/2010** and this record is true to the best of my knowledge and belief.
 Kansas Water Well Contractor's License No. **527** This Water Well Record was completed on (mo/day/yr) **7/18/2010**
 under the business name of **GeoCore, Inc.** by (signature) *Doc Bell*

OFFICE USE ONLY

T

R

EW

SEC

¼

¼

¼