


WATER WELL RECORD Form WW-5 KSA 82a-1212

1	LOCATION OF WATER WELL: County: <b>Mitchell</b>	Fraction <b>NE 1/4 SW 1/4 SE 1/4</b>	Section Number <b>27</b>	Township Number <b>T 6 S</b>	Range Number <b>R 9 E/W</b>
---	--	---	-----------------------------	---------------------------------	--------------------------------

Distance and direction from nearest town or city street address of well if located within city?  
**201 Hobart Street, Glen Elder**

2 WATER WELL OWNER: **Farmway Coop, Inc.**  
 RR#, St. Address, Box # : **P.O. Box 568**  
 City, State, ZIP Code : **Beloit, Kansas 67420**  
 Board of Agriculture, Division of Water Resources  
 Application Number: \_\_\_\_\_

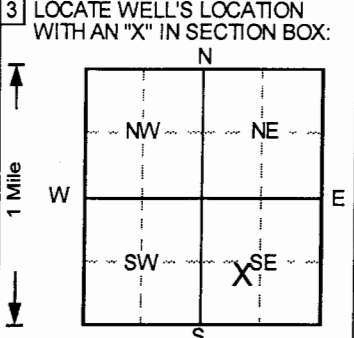

4 DEPTH OF COMPLETED WELL ..... **45** ..... ft ELEVATION: ..... **1425.05** .....

Depth(s) Groundwater Encountered 1. .... ft 2. .... ft 3. .... ft

WELL'S STATIC WATER LEVEL ... **33.18** ... ft below land surface measured on mo/day/yr ... **7/16/2010** .....

Pump test data: Well water was ... **NA** ... ft after ..... hours pumping ..... gpm  
 Est. Yield ... **NA** ... gpm: Well water was ..... ft after ..... hours pumping ..... gpm  
 Bore Hole Diameter ... **8** ... in. to ... **45** ... ft, and ..... in. to ..... ft

WELL WATER TO BE USED AS: 5 Public water supply 8 Air conditioning 11 Injection well  
 1 Domestic 3 Feedlot 6 Oil field water supply 9 Dewatering 12 Other (Specify below)  
 2 Irrigation 4 Industrial 7 Lawn and garden only **10** Monitoring well

Was a chemical/bacteriological sample submitted to Department? Yes ..... No  ; If yes, mo/day/yr sample was submitted  
 Water Well Disinfected? Yes No

5 TYPE OF BLANK CASING USED:

1 Steel	3 RMP (SR)	5 Wrought iron	8 Concrete tile	CASING JOINTS: Glued ..... Clamped .....
<b>2</b> PVC	4 ABS	6 Asbestos-Cement	9 Other (specify below)	Welded .....
Blank casing diameter ..... <b>2</b> ..... in. to ..... <b>30</b> ..... ft, Dia ..... in. to ..... ft, Dia ..... in. to ..... ft	7 Fiberglass	Threaded. <input checked="" type="checkbox"/>		
Casing height above land surface ..... <b>3</b> ..... in., weight ..... lbs./ft. Wall thickness or gauge No. ....	10 Asbestos-cement			

TYPE OF SCREEN OR PERFORATION MATERIAL

1 Steel	3 Stainless steel	5 Fiberglass	<b>7</b> PVC	10 Asbestos-cement
2 Brass	4 Galvanized steel	6 Concrete tile	8 RMP (SR)	11 Other (specify) .....
SCREEN OR PERFORATION OPENINGS ARE:	5 Gauzed wrapped	8 Saw cut	11 None (open hole)	
1 Continuous slot	<b>3</b> Mill slot	6 Wire wrapped	9 Drilled holes	
2 Louvered shutter	4 Key punched	7 Torch cut	10 Other (specify) .....	

SCREEN-PERFORATED INTERVALS: From ..... **30** ..... ft to ..... **45** ..... ft, From ..... ft to ..... ft  
 From ..... ft to ..... ft, From ..... ft to ..... ft  
 GRAVEL PACK INTERVALS: From ..... **27** ..... ft to ..... **45** ..... ft, From ..... ft to ..... ft  
 From ..... ft to ..... ft, From ..... ft to ..... ft

6 GROUT MATERIAL: 1 Neat cement **2** Cement grout **3** Bentonite 4 Other .....

Grout Intervals: From ..... **0** ..... ft to ..... **1** ..... ft, From ..... **1** ..... ft to ..... **27** ..... ft, From ..... ft to ..... ft

What is the nearest source of possible contamination:

1 Septic tank	4 Lateral lines	7 Pit privy	10 Livestock pens	14 Abandoned water well
2 Sewer lines	5 Cess pool	8 Sewage lagoon	11 Fuel storage	15 Oil well/Gas well
3 Watertight sewer lines	6 Seepage pit	9 Feedyard	12 Fertilizer storage	16 Other (specify below)
			13 Insecticide storage	

Direction from well? How many feet? \_\_\_\_\_

FROM	TO	LITHOLOGIC LOG	FROM	TO	PLUGGING INTERVALS
0	0.5	Concrete/Rebar,			
0.5	13	Sand, vf-c, fill, Lt. Brown			
13	19	Clay, v. silty, Gray Green			
19	24	Silt, sl. clayey, Gray Green			
24	29	Clay, sl. silty, Gray Green			
29	33	Silt, sl. clayey, Gray Green			
33	38	Sand, vf-c, occ. gravel, Gray Green			
38	45	Sand and gravel, vf-c w/f-m gravel,			
					MW5, Tag # 0045427, Flushmount

7 CONTRACTOR'S OR LANDOWNER'S CERTIFICATION: This water well was **1** constructed, **2** reconstructed, or **3** plugged under my jurisdiction and was completed on (mo/day/year) ..... **6/24/2010** ..... and this record is true to the best of my knowledge and belief.  
 Kansas Water Well Contractor's License No. .... **527** ..... This Water Well Record was completed on (mo/day/yr) ... **7/16/2010** ...  
 under the business name of **GeoCore, Inc.** by (signature) *Don*

OFFICE USE ONLY