


1 LOCATION OF WATER WELL: County: Mitchell Fraction NW 1/4 SE 1/4 SE 1/4 Section Number 27 Township Number T 6 S Range Number R 9 EW

Distance and direction from nearest town or city street address of well if located within city? 200 S. Hobart, Glen Elder

2 WATER WELL OWNER: Farmway Coop, Inc. RR#, St. Address, Box #: P.O. Box 568 City, State, ZIP Code: Beloit, Kansas 67420 Board of Agriculture, Division of Water Resources Application Number:

3 LOCATE WELL'S LOCATION WITH AN "X" IN SECTION BOX:

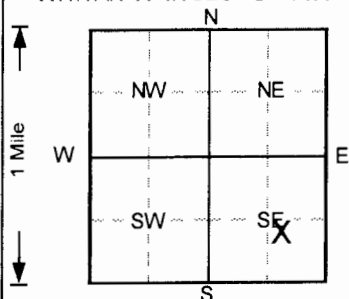

4 DEPTH OF COMPLETED WELL: 42 ft. ELEVATION: 1420.02. WELL'S STATIC WATER LEVEL: 33.22 ft. below land surface measured on 1/5/2011. Pump test data: Well water was NA ft. after ... hours pumping ... gpm. Est. Yield: NA gpm. Well water was ... ft. after ... hours pumping ... gpm. Bore Hole Diameter: 8 in. to 42 ft. and ... in. to ... ft. WELL WATER TO BE USED AS: 5 Public water supply 8 Air conditioning 11 Injection well 1 Domestic 3 Feedlot 6 Oil field water supply 9 Dewatering 12 Other (Specify below) 2 Irrigation 4 Industrial 7 Lawn and garden only 10 Monitoring well. Was a chemical/bacteriological sample submitted to Department? Yes No checked. If yes, mo/day/yr sample was submitted. Water Well Disinfected? Yes No checked.

5 TYPE OF BLANK CASING USED: 1 Steel 3 RMP (SR) 5 Wrought iron 8 Concrete tile CASING JOINTS: Glued Clamped Welded Threaded checked. 2 PVC 4 ABS 7 Fiberglass 9 Other (specify below)

Blank casing diameter: 2 in. to 27 ft. Dia. in. to ... ft. Dia. in. to ... ft. Casing height above land surface: -4.08 in., weight ... lbs./ft. Wall thickness or gauge No. Sch. 40

TYPE OF SCREEN OR PERFORATION MATERIAL: 1 Steel 3 Stainless steel 5 Fiberglass 7 PVC 10 Asbestos-cement 2 Brass 4 Galvanized steel 6 Concrete tile 8 RMP (SR) 11 Other (specify) 12 None used (open hole)

SCREEN OR PERFORATION OPENINGS ARE: 1 Continuous slot 3 Mill slot 5 Gauzed wrapped 8 Saw cut 11 None (open hole) 2 Louvered shutter 4 Key punched 6 Wire wrapped 9 Drilled holes 10 Other (specify) 7 Torch cut

SCREEN-PERFORATED INTERVALS: From 27 ft. to 42 ft. From ... ft. to ... ft. GRAVEL PACK INTERVALS: From 25 ft. to 42 ft. From ... ft. to ... ft.

6 GROUT MATERIAL: 1 Neat cement 2 Cement grout 3 Bentonite 4 Other Concrete. Grout intervals: From 0 ft. to 1 ft. From 1 ft. to 25 ft. From ... ft. to ... ft.

What is the nearest source of possible contamination: 1 Septic tank 4 Lateral lines 7 Pit privy 10 Livestock pens 14 Abandoned water well 2 Sewer lines 5 Cess pool 8 Sewage lagoon 11 Fuel storage 15 Oil well/Gas well 3 Watertight sewer lines 6 Seepage pit 9 Feedyard 12 Fertilizer storage 16 Other (specify below) 13 Insecticide storage

Direction from well? How many feet?

Table with columns FROM, TO, LITHOLOGIC LOG, FROM, TO, PLUGGING INTERVALS. Rows include: 0-2 Clay, silty, sandy, Dark Brown; 2-6 Clay, v. silty, Brown; 6-22 Clay, with abundant white caliche, silty, Brow; 22-28 Silt, sl. clayey, Yellow Brown; 28-34 Clay, silty, Brown; 34-38 Sand, f-c w/f gravel, Brown; 38-42 Sand, f-c w/incr. f-m gravel, Brown.

MW12, Tag # 0046255, Flushmount

7 CONTRACTOR'S OR LANDOWNER'S CERTIFICATION: This water well was (1) constructed, (2) reconstructed, or (3) plugged under my jurisdiction and was completed on (mo/day/year) 12/27/2011 and this record is true to the best of my knowledge and belief.

Kansas Water Well Contractor's License No. 527. This Water Well Record was completed on (mo/day/yr) 1/11/2011 under the business name of GeoCore, Inc. by (signature) [Handwritten Signature]

INSTRUCTIONS: Use typewriter or ball point pen. PLEASE PRESS FIRMLY and PRINT clearly. Please fill in blanks, underline or circle the correct answers. Send top three copies to Kansas Department of Health and Environment, Bureau of Water, Topeka, Kansas 66620-0001. Telephone: 913-296-5545. Send one to WATER WELL OWNER and retain one for your records.

OFFICE USE ONLY

T

R

EW

SEC.

1/2

1/4

1/4