


1 LOCATION OF WATER WELL:	Fraction County: Mitchell NW ¼ SE ¼ SE ¼	Section Number 27	Township Number T 6 S	Range Number R 9 E/W
---------------------------	---	----------------------	--------------------------	--------------------------------

Distance and direction from nearest town or city street address of well if located within city? **201 S. Hobart, Glen Elder**
 Lat. 39° 29' 51" Long. 98° 18' 22" (NAVD 88)

2 WATER WELL OWNER: **Farmway Coop, Inc.**
 RR#, St. Address, Box #: **P.O. Box 568**
 City, State, ZIP Code: **Beloit, Kansas 67420**
 Board of Agriculture, Division of Water Resources Application Number: _____

3 LOCATE WELL'S LOCATION WITH AN "X" IN SECTION BOX:

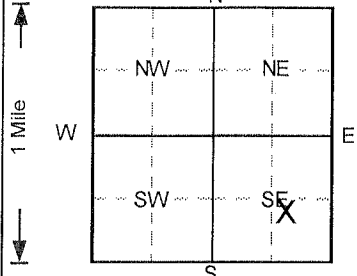

4 DEPTH OF COMPLETED WELL 42 ft. ELEVATION: 1424.95	Depth(s) Groundwater Encountered 1. ft. 2. ft. 3. ft.
WELL'S STATIC WATER LEVEL ... 31.75 ... ft. below land surface measured on mo/day/yr ... 7/7/2011	
Pump test data: Well water was ... NA ... ft. after ... hours pumping ... gpm	
Est. Yield ... NA ... gpm: Well water was ... ft. after ... hours pumping ... gpm	
Bore Hole Diameter ... 8 ... in. to ... 42 ... ft., and ... in. to ... ft.	

5 TYPE OF BLANK CASING USED:

1 Steel	3 RMP (SR)	5 Wrought iron	8 Concrete tile
2 PVC	4 ABS	6 Asbestos-Cement	9 Other (specify below)
Blank casing diameter ... 2 ... in. to ... 27 ... ft. Dia ... in. to ... ft. Dia ... in. to ... ft.		CASING JOINTS: Glued ... Clamped ...	
Casing height above land surface ... -5.52 ... in., weight ... lbs./ft. Wall thickness or gauge No. ... Sch. 40 ...		Welded ... Threaded. <input checked="" type="checkbox"/>	

TYPE OF SCREEN OR PERFORATION MATERIAL

1 Steel	3 Stainless steel	5 Fiberglass	8 RMP (SR)
2 Brass	4 Galvanized steel	6 Concrete tile	9 ABS
SCREEN OR PERFORATION OPENINGS ARE:		10 Asbestos-cement	
1 Continuous slot		11 Other (specify) ...	
2 Louvered shutter		12 None used (open hole)	
3 Mill slot		5 Gauzed wrapped	
4 Key punched		6 Wire wrapped	
SCREEN-PERFORATED INTERVALS: From ... 27 ... ft. to ... 42 ... ft., From ... ft. to ... ft.		7 Torch cut	
GRAVEL PACK INTERVALS: From ... 25 ... ft. to ... 42 ... ft., From ... ft. to ... ft.		8 Saw cut	
		9 Drilled holes	
		10 Other (specify) ...	
		11 None (open hole)	

6 GROUT MATERIAL: 1 Neat cement 2 Cement grout 3 **Bentonite** 4 **Other Concrete**

Grout Intervals: From ... **0** ... ft. to ... **1** ... ft., From ... **1** ... ft. to ... **25** ... ft., From ... ft. to ... ft.

What is the nearest source of possible contamination:

1 Septic tank	4 Lateral lines	7 Pit privy	10 Livestock pens
2 Sewer lines	5 Cess pool	8 Sewage lagoon	11 Fuel storage
3 Watertight sewer lines	6 Seepage pit	9 Feedyard	12 Fertilizer storage
			13 Insecticide storage
			14 Abandoned water well
			15 Oil well/Gas well
			16 Other (specify below)

FROM	TO	LITHOLOGIC LOG	FROM	TO	PLUGGING INTERVALS
0	6	Clay, silty, Brown			
6	11	Silt, sl. clayey, Lt. Brown			
11	16	Clay, silty, Brown			
16	19	Clay, v. silty, V. Lt. Brown			
19	29	Clay, sl. silty, Brown			
29	36	Clay, silty, Brown to Lt. Brown			
36	39	Clay, v. silty, Brown			
39	42	Sand and gravel, vf-c w/f gravel, Yellow Brow			
MW15, Tag # 0046813, Flushmount					

7 CONTRACTOR'S OR LANDOWNER'S CERTIFICATION: This water well was (1) constructed, (2) reconstructed, or (3) plugged under my jurisdiction and was completed on (mo/day/year) ... **6/30/2011** ... and this record is true to the best of my knowledge and belief.

Kansas Water Well Contractor's License No. ... **527** ... This Water Well Record was completed on (mo/day/yr) ... **7/28/2011** ...

under the business name of **GeoCore, Inc.** by (signature) *Dale Kels*

OFFICE USE ONLY T R EW SEC 1/4 1/4