


WATER WELL PLUGGING RECORD Form WWC-5P KSA 82a-1212 ID NO.

MW3

1 LOCATION OF WATER WELL: County: Mitchell	Fraction NW ¼ NW ¼ SE ¼ SE ¼	Section Number 27	Township Number T 6 S	Range Number 9 <input type="checkbox"/> E <input checked="" type="checkbox"/> W
--	---------------------------------	----------------------	--------------------------	--

Street/Rural Address of Well Location; if unknown, distance & direction from nearest town or intersection: If at owner's address, check here <input type="checkbox"/> ~85' SE of 203 S Hobart, Glen Elder, KS	Global Positioning Systems (GPS) information: Latitude: 39°29'51.61"N (in decimal degrees) Longitude: 98°18'22.33"W (in decimal degrees) Elevation: NA Horizontal Datum <input type="checkbox"/> WGS84, <input checked="" type="checkbox"/> NAD83, <input type="checkbox"/> NAD27 Collection Method: <input type="checkbox"/> GPS unit (Make/model: _____) <input type="checkbox"/> Digital Map/Photo, <input type="checkbox"/> Topographic Map <input type="checkbox"/> Land Survey Est. Accuracy: <input type="checkbox"/> <3 m, <input type="checkbox"/> 3-5 m, <input type="checkbox"/> 5-15 m, <input type="checkbox"/> >15 m
--	---

2 WATER WELL OWNER: Farmway Coop, Inc.
RR#, St. Address, Box #: PO Box 568
City, State ZIP Code: Beloit, KS 67420

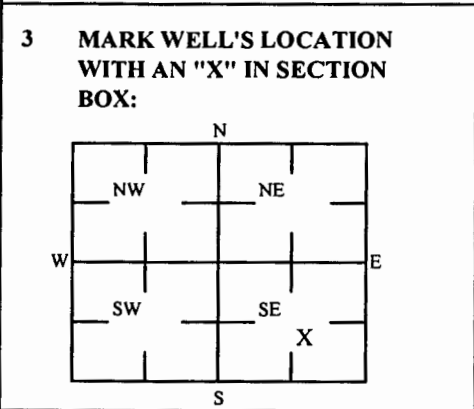

4 DEPTH OF WELL 42.9 ft.
WELL'S STATIC WATER LEVEL NA ft
WELL WAS USED AS:
 Domestic Public Water Supply Dewatering
 Irrigation Oil Field Water Supply Monitoring
 Feedlot Domestic (Lawn & Garden) Injection Well
 Industrial Air Conditioning Other _____
Was a chemical/bacteriological sample submitted to Department? Yes No

5 TYPE OF BLANK CASING USED:

Steel RMP (SR) Wrought Fiberglass Other (Specific below)
 PVC ABS Asbestos-Cement Concrete Tile _____

Blank casing diameter 2 in. Was casing pulled? Yes No If yes, how much 3'
Casing height above or below land surface NA in.

6 GROUT PLUG MATERIAL: Neat cement Cement grout Bentonite Other Gravel: 0-1'; Soil: 1-3'

Grout Plug Intervals: From 3 ft to 42.9 ft, From _____ ft to _____ ft, From _____ ft to _____ ft,

What is the nearest source of possible contamination:
 Septic tank Seepage pit Fuel storage Other (specify below) _____
 Sewer lines Pit privy Fertilizer storage _____
 Watertight sewer lines Sewage lagoon Insecticide storage _____
 Lateral lines Feed yard Abandoned water well _____
 Cess pool Livestock pens Oil well/Gas well _____

Direction from well? _____
How many feet? _____

FROM	TO	PLUGGING MATERIALS	FROM	TO	PLUGGING MATERIALS
0	1	Gravel			
1	3	Soil			
3	42.9	Bentonite			

KDHE ID: Farmway Coop Inc. - Glen Elder Service Station; A5-062-40358

7 CONTRACTOR'S OR LANDOWNER'S CERTIFICATION: This water well was plugged under my jurisdiction and was completed on (mo/day/year) 12/19-20/22 and this record is true to the best of my knowledge and belief. Kansas Water Contractor's License No. 757. This Water Well Record was completed on (mo/day/year) 1/5/2023 under the business name of Larsen & Associates, Inc. By (signature) _____

Send one white copy to Kansas Department of Health & Environment, Geology Section, 1000 SW Jackson Street, Ste. 420, Topeka, KS 66612-1367. Send one copy to WATER WELL OWNER and retain one for your records
Visit us at <http://www.kdheks.gov/waterwell/index.html> Telephone 785-296-5524.

NOTE: Figures exhibited within this report are only to be used within the context of this report. Placement of property lines, wells, structures, and roads is based on the available information from county appraiser maps, surveys, site visits, and/or previous vendor reports and should be considered approximate.

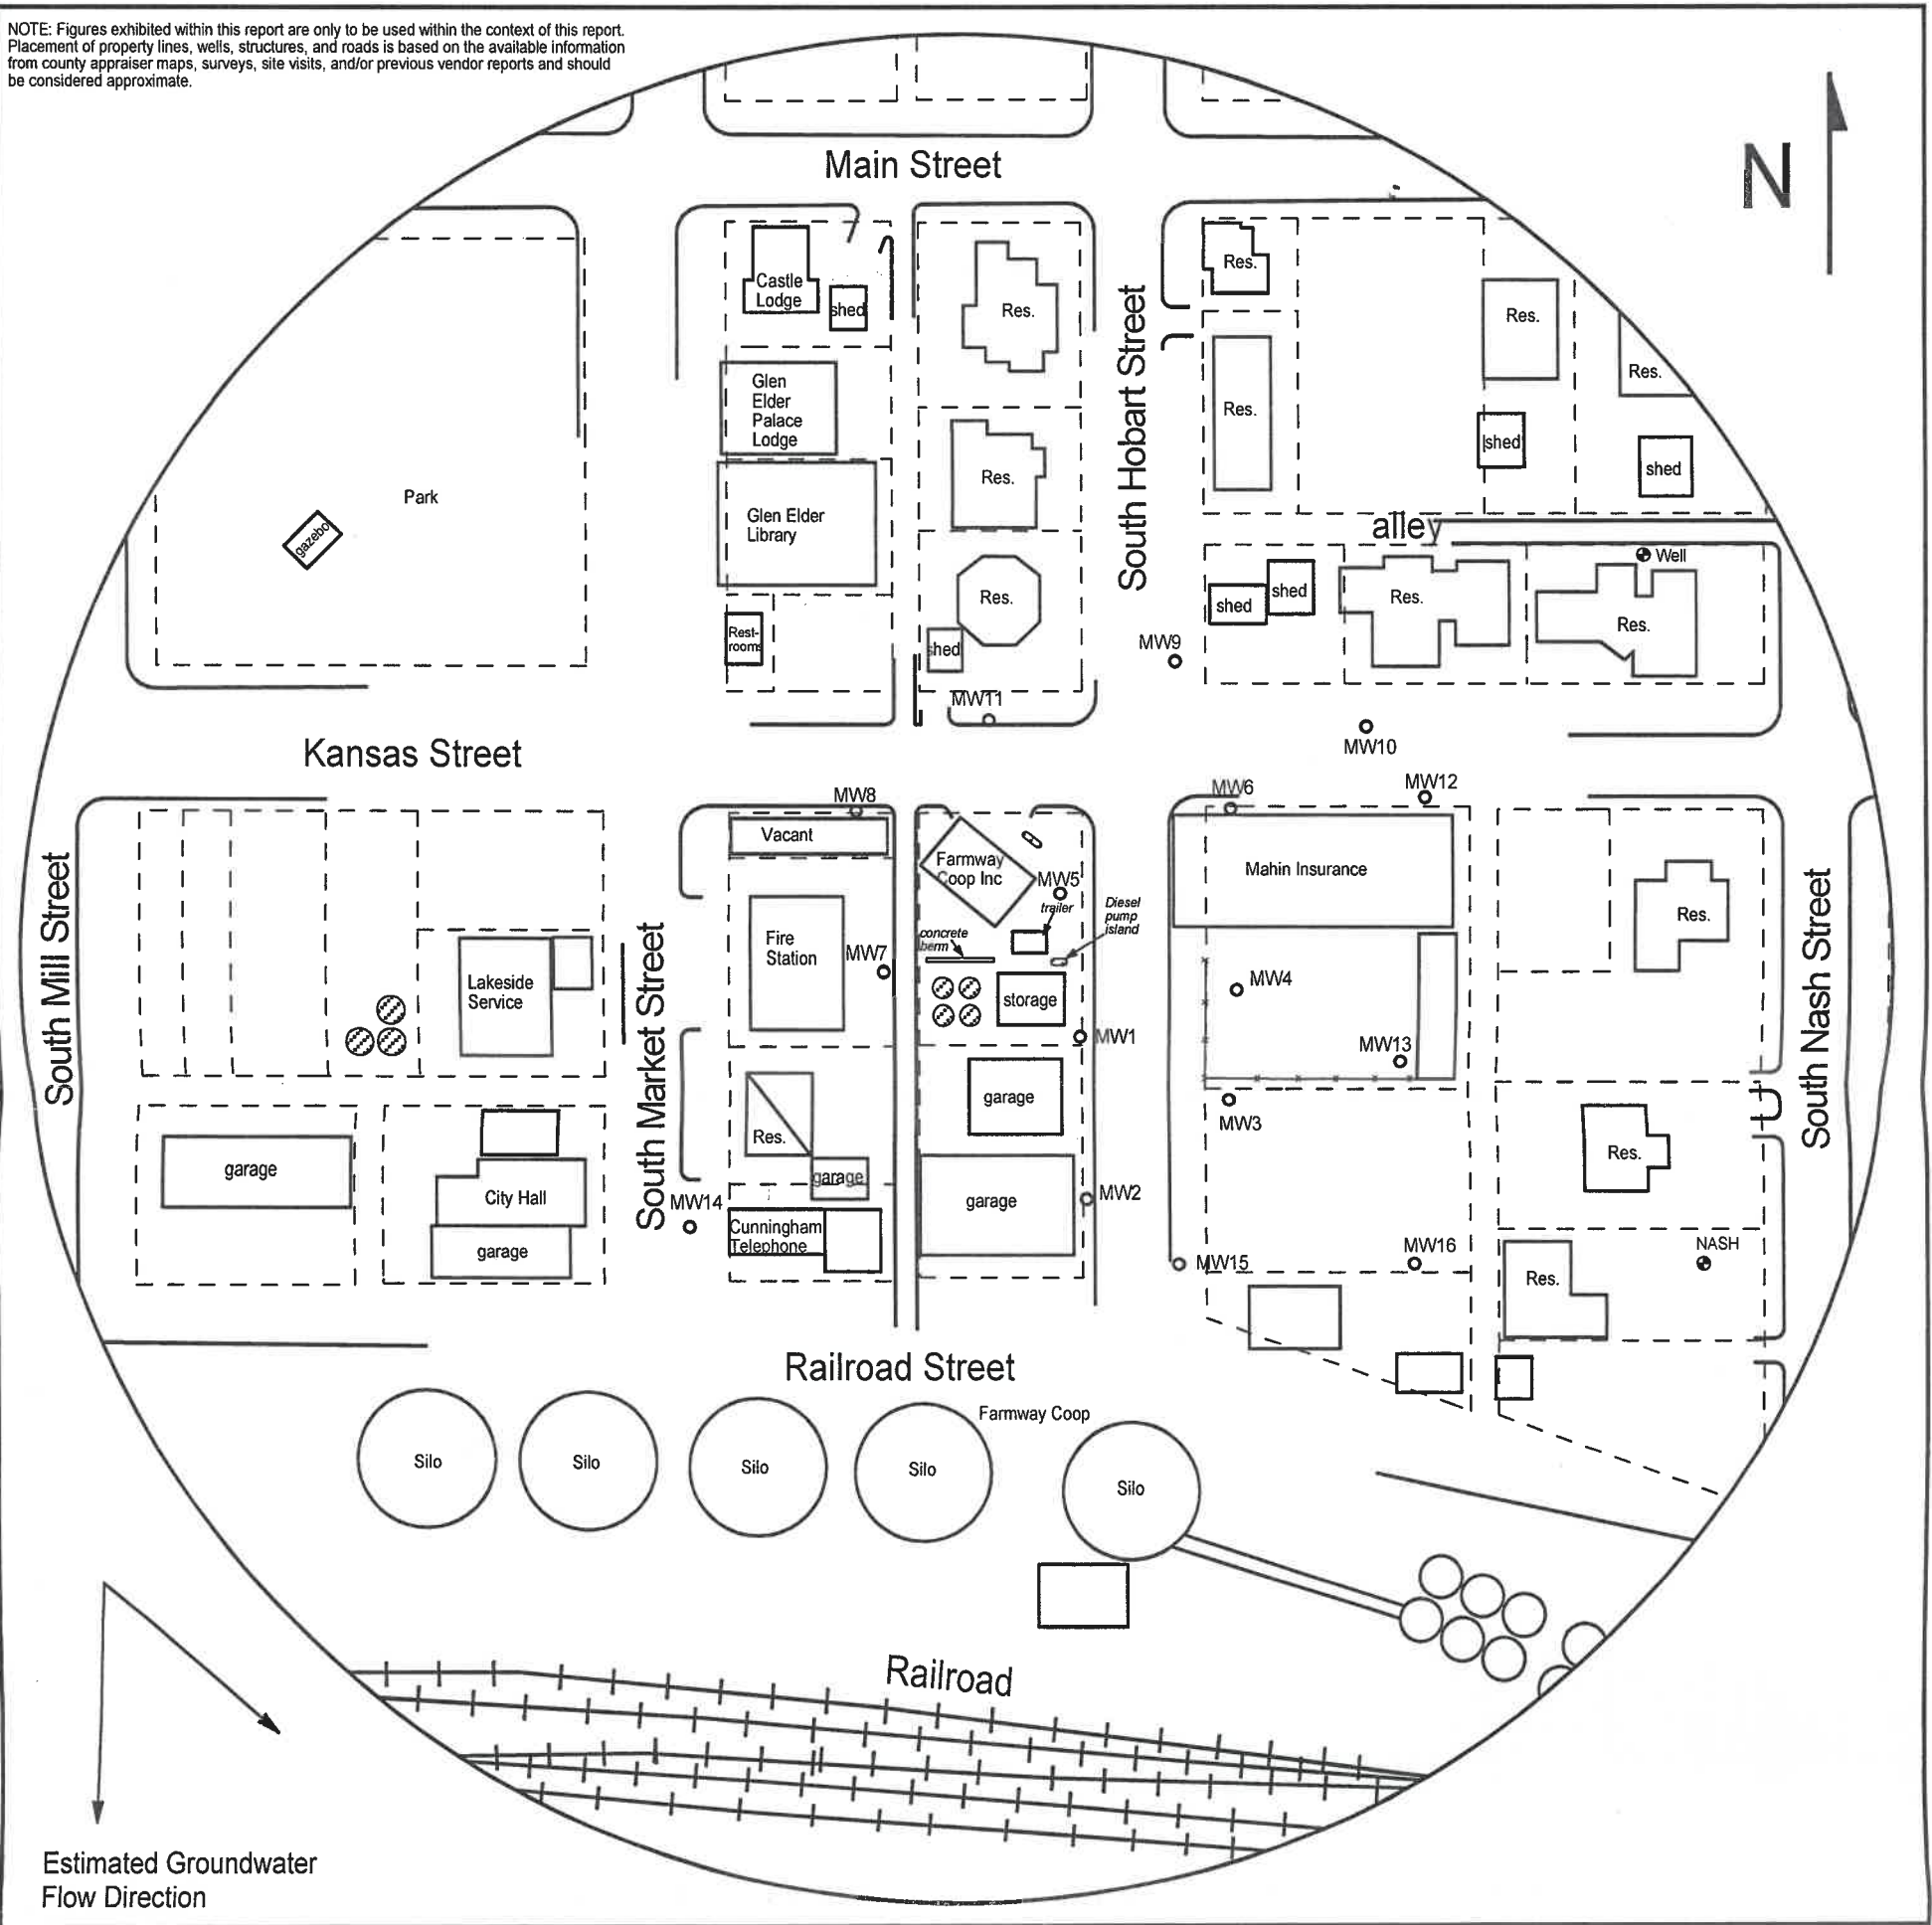


FIGURE 1 - 500 FT RADIUS AREA BASE MAP

LEGEND

- Approximate Location of Former ASTs & Pump Islands
 - Building with Basement
 - Approximate Location of Property Line
 - Plugged Monitoring Well
 - Lawn & Garden Well
- T6 R.9W S4C.27
Mitchell County

NOTE: Location of product lines is unknown.



PROJECT:

Farmway Coop Inc. -
Glen Elder Service Station
203 S. Hobart
Glen Elder, KS
KDHE ID: A5-062-40358
Date: 12/19-20/22



1311 E 25th St., Suite B 785-841-8707 office
Lawrence, KS 66046 785-865-4282 fax