USE TYPEWRITER OR BALL POINT PEN-PRESS FIRMLY, PRINT CLEARLY.

T R EW sec 1/4 1/4 1/4 No.

WATER WELL RECORD
KSA 82a-1201-1215

Kansas State Dept. Of Health
(Water Well Contractors)
Forbes-Bldg. 740
Topeka, Kansas 66620

1 Location of well:	County	Township name	Fraction	Section number	Town number	Range number
	Osborne	Corinth	NWSWSW	27	T7S	R11W

Distance and direction from nearest town or city: 5½ S of Downs KS

Street address of well location if in city:

3 Owner of well: Louis Bohm

Address: Downs Kansas

Locote with "X" in section below:

Sketch map:

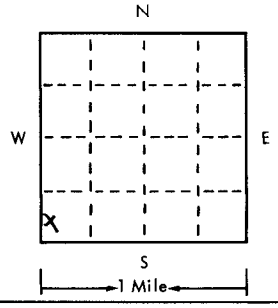

4 Well depth: 48 ft. Date of completion 6-11-75
Well diameter 8 in.

5 ☐ Cable tool ☒ Rotary ☐ Driven ☐ Dug
☐ Hollow rod ☐ Jetted ☐ Bored ☐ Reverse rotary

6 Use: ☐ Domestic ☐ Public supply ☐ Industry
☒ Irrigation ☐ Air conditioning ☐ Commercial
☐ Test well ☐

7 Casing: Material Plastic Height: above/below
Threaded ☐ Welded ☐ Surface 13 in.
Diam. Weight 200 lbs./ft.
5 in. to 48 ft. depth Drive shoe? ☐ Yes ☐ No
in. to ft. depth

2 Type and color of material	From	To
Top soil & Clays	0	25
Sand & gravel w/broken rocks	25	44
Shale	44	50