


1 LOCATION OF WATER WELL: County: Osborne	Fraction NW 1/4 NE 1/4 NW 1/4	Section Number 20	Township Number T 7 S	Range Number R 12
---	---	-----------------------------	---------------------------------	-----------------------------

Distance and direction from nearest town or city street address of well if located within city?

East Main Street, Osborne, Kansas 67473

2 WATER WELL OWNER: Osborne County RR#, St. Address, Box # : P.O. Box 347 City, State, ZIP Code : Osborne, Kansas 67473	Board of Agriculture, Division of Water Resources Application Number:
--	--

3 LOCATE WELL'S LOCATION WITH AN "X" IN SECTION BOX:

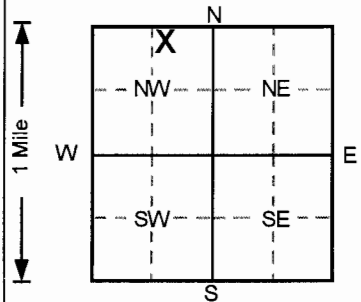

4 DEPTH OF COMPLETED WELL **30.5** ft. ELEVATION:

Depth(s) Groundwater Encountered 1. ft. 2. ft. 3. ft.

WELL'S STATIC WATER LEVEL ft. below land surface measured on mo/day/yr

Pump test data: Well water was **NA** ft. after hours pumping gpm

Est. Yield **NA** gpm: Well water was ft. after hours pumping gpm

Bore Hole Diameter **8** in. to **30.5** ft., and in. to ft.

WELL WATER TO BE USED AS: 5 Public water supply 8 Air conditioning 11 Injection well
1 Domestic 3 Feedlot 6 Oil field water supply 9 Dewatering **12 Other (Specify below)**
2 Irrigation 4 Industrial 7 Lawn and garden only 10 Monitoring well **Soil Vapor**

Was a chemical/bacteriological sample submitted to Department? Yes.....No ; If yes, mo/day/yr sample was submitted

Water Well Disinfected? Yes No

5 TYPE OF BLANK CASING USED:

1 Steel	3 RMP (SR)	5 Wrought iron	8 Concrete tile	CASING JOINTS: Glued Clamped
2 PVC	4 ABS	6 Asbestos-Cement	9 Other (specify below)	Welded
		7 Fiberglass		Threaded. <input checked="" type="checkbox"/>

Blank casing diameter **2** in. to **27.5** ft., Dia in. to ft., Dia in. to ft.

Casing height above land surface **0** in., weight lbs./ft. Wall thickness or gauge No. **Sch. 40**

TYPE OF SCREEN OR PERFORATION MATERIAL

1 Steel	3 Stainless steel	5 Fiberglass	7 PVC	10 Asbestos-cement
2 Brass	4 Galvanized steel	6 Concrete tile	8 RMP (SR)	11 Other (specify)
			9 ABS	12 None used (open hole)

SCREEN OR PERFORATION OPENINGS ARE:

1 Continuous slot	3 Mill slot	5 Gauzed wrapped	8 Saw cut	11 None (open hole)
2 Louvered shutter	4 Key punched	6 Wire wrapped	9 Drilled holes	
		7 Torch cut	10 Other (specify)	

SCREEN-PERFORATED INTERVALS: From **27.5** ft. to **30.5** ft., From ft. to ft.

GRAVEL PACK INTERVALS: From **27** ft. to **30.5** ft., From ft. to ft.

6 GROUT MATERIAL: 1 Neat cement **2 Cement grout** **3 Bentonite** 4 Other

Grout Intervals: From **0** ft. to **3** ft., From **3** ft. to **27** ft., From ft. to ft.

What is the nearest source of possible contamination:

1 Septic tank	4 Lateral lines	7 Pit privy	10 Livestock pens	14 Abandoned water well
2 Sewer lines	5 Cess pool	8 Sewage lagoon	11 Fuel storage	15 Oil well/Gas well
3 Watertight sewer lines	6 Seepage pit	9 Feedyard	12 Fertilizer storage	16 Other (specify below)
			13 Insecticide storage	Former UST Basin

Direction from well? **SE** How many feet? **50**

FROM	TO	LITHOLOGIC LOG	FROM	TO	PLUGGING INTERVALS
0	1	Clay, Dark Brown Orange			
1	5	Clay, Dark Brown			
5	7	Clay, Dark to Medium Brown			
7	15	Clay, Dark to Medium Brown to Gray Brown			
15	23	Clay, Dark to Medium Gray Brown			
23	25	Clay, Gray Brown			
25	28	Clay, Dark Brown			
28	30	Sand, Light Gray			
					SV1, Tag # 00114275, Flushmount
					Project Name: Osborne County
					GeoCore # 17, KDHE # U6 071 364

7 CONTRACTOR'S OR LANDOWNER'S CERTIFICATION: This water well was **(1)** constructed, (2) reconstructed, or (3) plugged under my jurisdiction and was completed on (mo/day/year) **4/13/93** and this record is true to the best of my knowledge and belief.

Kansas Water Well Contractor's License No. **527** This Water Well Record was completed on (mo/day/yr) **5/12/93** under the business name of **GeoCore Services, Inc.** by (signature) *Don Robb*

OFFICE USE ONLY

T

R

EW

SEC.

1/2

1/2

1/2