


1 LOCATION OF WATER WELL: County: Osborne Fraction: NW 1/4 NE 1/4 NW 1/4 Section Number: 20 Township Number: T 7 S Range Number: R 12 E/W

Distance and direction from nearest town or city street address of well if located within city?

East Main Street, Osborne, Kansas 67473

2 WATER WELL OWNER: Osborne County RR#, St. Address, Box #: P.O. Box 347 City, State, ZIP Code: Osborne, Kansas 67473 Board of Agriculture, Division of Water Resources Application Number:

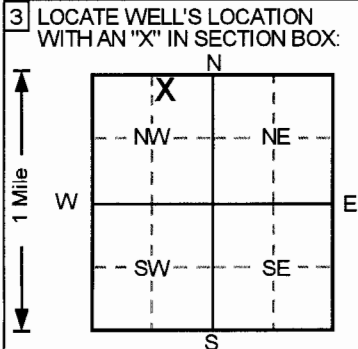

3 LOCATE WELL'S LOCATION WITH AN 'X' IN SECTION BOX: 4 DEPTH OF COMPLETED WELL: 30.5 ft. ELEVATION: ... WELL'S STATIC WATER LEVEL: ... Pump test data: ... Est. Yield: ... Bore Hole Diameter: 8 in. to 30.5 ft. ... WELL WATER TO BE USED AS: ... Was a chemical/bacteriological sample submitted?

5 TYPE OF BLANK CASING USED: 1 Steel, 2 PVC, 3 RMP (SR), 4 ABS, 5 Wrought iron, 6 Asbestos-Cement, 7 Fiberglass, 8 Concrete tile, 9 Other, 10 Asbestos-cement, 11 Other. SCREEN OR PERFORATION MATERIAL: 1 Steel, 2 Brass, 3 Stainless steel, 4 Galvanized steel, 5 Fiberglass, 6 Concrete tile, 7 PVC, 8 RMP (SR), 9 ABS, 10 Asbestos-cement, 11 Other, 12 None used. SCREEN OR PERFORATION OPENINGS ARE: 1 Continuous slot, 2 Louvered shutter, 3 Mill slot, 4 Key punched, 5 Gauzed wrapped, 6 Wire wrapped, 7 Torch cut, 8 Saw cut, 9 Drilled holes, 10 Other, 11 None. SCREEN-PERFORATED INTERVALS: From 27.5 ft. to 30.5 ft. GRAVEL PACK INTERVALS: From 27 ft. to 30.5 ft.

6 GROUT MATERIAL: 1 Neat cement, 2 Cement grout, 3 Bentonite, 4 Other. Grout Intervals: From 0 ft. to 3 ft., From 3 ft. to 27 ft. What is the nearest source of possible contamination: 1 Septic tank, 2 Sewer lines, 3 Watertight sewer lines, 4 Lateral lines, 5 Cess pool, 6 Seepage pit, 7 Pit privy, 8 Sewage lagoon, 9 Feedyard, 10 Livestock pens, 11 Fuel storage, 12 Fertilizer storage, 13 Insecticide storage, 14 Abandoned water well, 15 Oil well/Gas well, 16 Other (specify below): Former UST Basin. Direction from well? S How many feet? 35

FROM	TO	LITHOLOGIC LOG	FROM	TO	PLUGGING INTERVALS
0	1	Clay, Dark Brown Orange			
1	5	Clay, Dark Brown			
5	7	Clay, Dark to Medium Brown			
7	13	Clay, Dark to Medium Brown to Gray Brown			
13	15	Clay, Dark to Medium Brown			
15	19.5	Clay, Dark to Medium Gray Brown			
19.5	26	Sand, Medium to Light Brown to Gray Brown			
26	30.5	Clay, Medium to Dark Brown			
					SV2, Tag # 00114251, Flushmount
					Project Name: Osborne County
					GeoCore # 17, KDHE # U6 071 364

7 CONTRACTOR'S OR LANDOWNER'S CERTIFICATION: This water well was (1) constructed, (2) reconstructed, or (3) plugged under my jurisdiction and was completed on (mo/day/year) 4/13/93 and this record is true to the best of my knowledge and belief. Kansas Water Well Contractor's License No. 527 This Water Well Record was completed on (mo/day/year) 5/12/93 under the business name of GeoCore Services, Inc. by (signature) Dae Koll