


1 LOCATION OF WATER WELL: County: OSBORNE	Fraction <i>NE NW SW NW</i> SW 1/4 SW 1/4 SW 1/4	Section Number 20	Township Number T 7 S	Range Number R 12 EW
--	--	----------------------	--------------------------	------------------------------------

Distance and direction from nearest town or city street address of well if located within city?
200 E VERMONT OSBORNE KS

2 WATER WELL OWNER: OSBORNE HOUSING AUTHORITY
RR#, St. Address, Box # : 200 E VERMONT Board of Agriculture, Division of Water Resources
City, State, ZIP Code : OSBORNE KS 67473 Application Number:

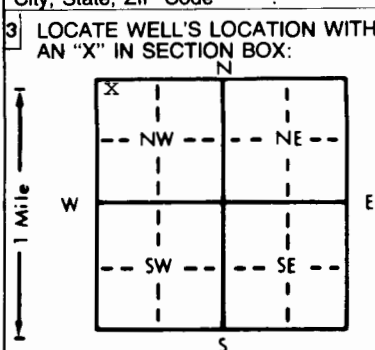

4 DEPTH OF COMPLETED WELL: 42 ft. ELEVATION:
Depth(s) Groundwater Encountered 1. 28 ft. 2. ft. 3. ft.
WELL'S STATIC WATER LEVEL: 28 ft. below land surface measured on mo/day/yr 9-10-01
Pump test data: Well water was ft. after hours pumping gpm
Est. Yield 22 gpm: Well water was ft. after hours pumping gpm
Bore Hole Diameter: 10 in. to 42 ft., and in. to ft.
WELL WATER TO BE USED AS:
5 Public water supply 8 Air conditioning 11 Injection well
1 Domestic 3 Feedlot 6 Oil field water supply 9 Dewatering 12 Other (Specify below)
2 Irrigation 4 Industrial Lawn and garden only 10 Monitoring well
Was a chemical/bacteriological sample submitted to Department? Yes.....No. ; if yes, mo/day/yr sample was submitted
Water Well Disinfected? Yes No

5 TYPE OF BLANK CASING USED:
1 Steel 3 RMP (SR) 5 Wrought iron 8 Concrete tile CASING JOINTS: Glued... Clamped...
 PVC 4 ABS 6 Asbestos-Cement 9 Other (specify below) Welded...
7 Fiberglass Threaded...
Blank casing diameter . in. to 28 ft., Dia . in. to ft., Dia . in. to ft.
Casing height above land surface . in., weight 160 lbs./ft. Wall thickness or gauge No. .
TYPE OF SCREEN OR PERFORATION MATERIAL: PVC 10 Asbestos-cement
1 Steel 3 Stainless steel 5 Fiberglass 8 RMP (SR) 11 Other (specify) .
2 Brass 4 Galvanized steel 6 Concrete tile 9 ABS 12 None used (open hole)
SCREEN OR PERFORATION OPENINGS ARE:
1 Continuous slot Mill slot 5 Gauzed wrapped 8 Saw cut 11 None (open hole)
2 Louvered shutter 4 Key punched 6 Wire wrapped 9 Drilled holes
7 Torch cut 10 Other (specify) .
SCREEN-PERFORATED INTERVALS: From 28 ft. to 42 ft., From ft. to ft.
GRAVEL PACK INTERVALS: From 28 ft. to 42 ft., From ft. to ft.

6 GROUT MATERIAL: 1 Neat cement 2 Cement grout Bentonite 4 Other .
Grout Intervals: From 0 ft. to 28 ft., From ft. to ft., From ft. to ft.
What is the nearest source of possible contamination:
1 Septic tank 4 Lateral lines 7 Pit privy 10 Livestock pens 14 Abandoned water well
2 Sewer lines 5 Cess pool 8 Sewage lagoon 11 Fuel storage 15 Oil well/Gas well
3 Watertight sewer lines 6 Seepage pit 9 Feedyard 12 Fertilizer storage 16 Other (specify below)
13 Insecticide storage .
Direction from well? How many feet?

FROM	TO	LITHOLOGIC LOG	FROM	TO	PLUGGING INTERVALS
0	2	SURFACE CLAY			
2	18	HARD GRAY CLAY			
18	25	MED SOFT GRAY CLAY			
25	32	SUGAR Ø SAND			
32	36	MED SAND			
36	42	BLUE SHALE			

7 CONTRACTOR'S OR LANDOWNER'S CERTIFICATION: This water well was constructed, (2) reconstructed, or (3) plugged under my jurisdiction and was completed on (mo/day/year) 9-10-01 and this record is true to the best of my knowledge and belief. Kansas Water Well Contractor's License No. 444 This Water Well Record was completed on (mo/day/yr) 9-11-01 under the business name of ANDY ANDERSON DRILLING by (signature) *Andy Anderson*

OFFICE USE ONLY
T
R
EW
SEC
1/4
1/4
1/4