


1	LOCATION OF WATER WELL:	Fraction	Section Number	Township Number	Range Number
	County: <u>OSBORNE</u>	<u>NW 1/4 NE 1/4 NW 1/4</u>	<u>20</u>	<u>7</u>	<u>12</u>

Distance and direction from nearest town or city street address of well if located within city?

EAST MAIN STREET, OSBORNE, KANSAS 67473

2	WATER WELL OWNER: <u>OSBORNE COUNTY HIGHWAY DEPT.</u>	Board of Agriculture, Division of Water Resources
	RR #, St. Address, Box #: <u>P.O. BOX 347</u>	Application Number:
	City, State, ZIP Code: <u>OSBORNE KANSAS 67473</u>	

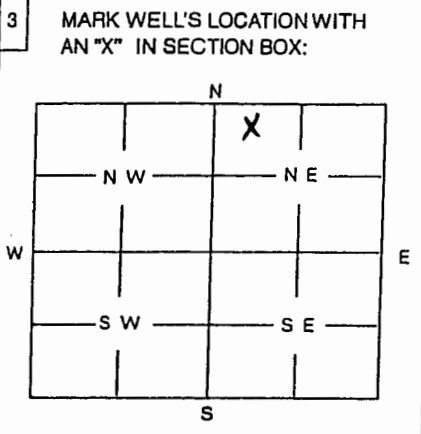

4	DEPTH OF WELL <u>50</u> ft												
	WELL'S STATIC WATER LEVEL ... <u>NA</u> ft.												
	WELL WAS USED AS:												
	<table border="0"> <tr> <td>1 Domestic</td> <td>5 Public Water Supply</td> <td>9 Dewatering</td> </tr> <tr> <td>2 Irrigation</td> <td>6 Oil Field Water Supply</td> <td>10 Monitoring Well</td> </tr> <tr> <td>3 Feedlot</td> <td>7 Domestic (Lawn & Garden)</td> <td>11 Injection Well</td> </tr> <tr> <td>4 Industrial</td> <td>8 Air Conditioning</td> <td>12 Other <u>RECOVERY WELL</u></td> </tr>
	Was a chemical / bacteriological sample submitted to Department? Yes No <input checked="" type="checkbox"/>												
	If yes, mo/day/yr sample was submitted												
	Water Well Disinfected: Yes No <input checked="" type="checkbox"/>												

5	TYPE OF BLANK CASING USED:										
	<table border="0"> <tr> <td>1 Steel</td> <td>3 RMP (SR)</td> <td>5 Wrought</td> <td>7 Fiberglass</td> <td>9 Other (Specify below)</td> </tr> <tr> <td>2 PVC</td> <td>4 ABS</td> <td>6 Asbestos-Cement</td> <td>8 Concrete Tile</td> <td></td> </tr> </table>	1 Steel	3 RMP (SR)	5 Wrought	7 Fiberglass	9 Other (Specify below)	2 PVC	4 ABS	6 Asbestos-Cement	8 Concrete Tile	
1 Steel	3 RMP (SR)	5 Wrought	7 Fiberglass	9 Other (Specify below)							
2 PVC	4 ABS	6 Asbestos-Cement	8 Concrete Tile								
	Blank casing diameter <u>2</u> in. Was casing pulled? Yes No If yes, how much										
	Casing height above or below land surface <u>10</u> in.										

6	GROUT PLUG MATERIAL:																				
	<table border="0"> <tr> <td>1 Neat cement</td> <td>2 Cement grout</td> <td>3 Bentonite</td> <td>4 Other <u>COARSE SAND</u></td> </tr> </table>	1 Neat cement	2 Cement grout	3 Bentonite	4 Other <u>COARSE SAND</u>																
1 Neat cement	2 Cement grout	3 Bentonite	4 Other <u>COARSE SAND</u>																		
	Grout Plug Intervals: From <u>0'</u> ft. to <u>25'</u> ft., From <u>25'</u> ft. to <u>50'</u> ft., From to ft.																				
	What is the nearest source of possible contamination:																				
	<table border="0"> <tr> <td>1 Septic tank</td> <td>6 Seepage pit</td> <td>11 Fuel storage</td> <td>16 Other (specify below)</td> </tr> <tr> <td>2 Sewer lines</td> <td>7 Pit privy</td> <td>12 Fertilizer storage</td> <td></td> </tr> <tr> <td>3 Watertight sewer lines</td> <td>8 Sewage lagoon</td> <td>13 Insecticide storage</td> <td></td> </tr> <tr> <td>4 Lateral lines</td> <td>9 Feedyard</td> <td>14 Abandoned water well</td> <td></td> </tr> <tr> <td>5 Cess Pool</td> <td>10 Livestock pens</td> <td>15 Oil well/Gas well</td> <td></td> </tr>
	Direction from well? <u>N</u> How many feet? <u>40'</u>																				

FROM	TO	PLUGGING MATERIALS
<u>0'</u>	<u>25'</u>	<u>BENTONITE 2"</u>
<u>25'</u>	<u>50'</u>	<u>COARSE SAND 2"</u>

RW1

7	CONTRACTOR'S OR LANDOWNER'S CERTIFICATION: This water well was plugged under my jurisdiction and was completed on (mo/day/year) <u>5/7/03</u> and this record is true to the best of my knowledge and belief. Kansas Water Well Contractor's License No. <u>527</u> This Water Well Record was completed on (mo/day/year) <u>6/7/03</u> under the business name of <u>GEOCORE</u> by (signature) <u>Doc Hall</u>
---	--

INSTRUCTIONS: Use typewriter or ball point pen. Please press firmly and print clearly. Please fill in blanks, underline or circle the correct answers. Send top three copies to Kansas Department of Health and Environment, Bureau of Water, Topeka, Kansas 66620-0001. Telephone: 785/296-3565. Send one to Water Well Owner and retain one for your records.