

1 LOCATION OF WATER WELL: Fraction Township Number Range Number
 County: OSBORN SW 1/4 NW 1/4 NE 1/4 1B T 7 S R 12 E 10

Distance and direction from nearest town or city street address of well if located within city?

110 MERCURY AVE, OSBORN, KS

LAT: 39° 26.960


LONG: 98° 41.546

2 WATER WELL OWNER: LANCE WOLTERS

RR#, St. Address, Box # : 110 MERCURY AVE
 City, State, ZIP Code : OSBORN, KS 67473

Board of Agriculture, Division of Water Resources
 Application Number: _____

3 LOCATE WELL'S LOCATION WITH AN "X" IN SECTION BOX: 4 DEPTH OF COMPLETED WELL 200 ft. ELEVATION: _____

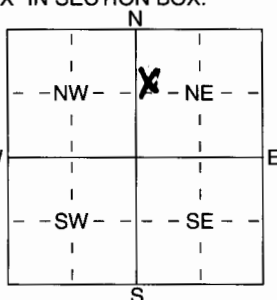

Depth(s) Groundwater Encountered 1 55 ft. 2 _____ ft. 3 _____ ft.
 WELL'S STATIC WATER LEVEL _____ ft. below land surface measured on mo/day/yr _____

Pump test data: Well water was _____ ft. after _____ hours pumping _____ gpm
 Est. Yield _____ gpm: Well water was _____ ft. after _____ hours pumping _____ gpm

WELL WATER TO BE USED AS: 5 Public water supply 8 Air conditioning 11 Injection well
 1 Domestic 3 Feedlot 6 Oil field water supply 9 Dewatering 12 Other (Specify below)
 2 Irrigation 4 Industrial 7 Domestic (lawn & garden) 10 Monitoring well CLOSED WELP. W/ OTHER MATERIAL

Was a chemical/bacteriological sample submitted to Department? Yes _____ No X; If yes, mo/day/yr sample was submitted
 Water Well Disinfected? Yes X No X

5 TYPE OF BLANK CASING USED: 5 Wrought iron 8 Concrete tile CASING JOINTS: Glued _____ Clamped _____
 1 Steel 3 RMP (SR) 6 Asbestos-Cement Other (Specify below) Welded X
 2 PVC 4 ABS 7 Fiberglass HOPK Threaded _____

Blank casing diameter 3/4 in. to 2.00 ft., Dia _____ in. to _____ ft., Dia _____ in. to _____ ft.
 Casing height above land surface 60 in., weight _____ lbs./ft. Wall thickness or gauge No. SPR 11

TYPE OF SCREEN OR PERFORATION MATERIAL: 7 PVC 10 Asbestos-Cement
 1 Steel 3 Stainless Steel 5 Fiberglass 8 RMP (SR) 11 Other (Specify)
 2 Brass 4 Galvanized Steel 6 Concrete tile 9 ABS 12 None used (open hole)

SCREEN OR PERFORATION OPENINGS ARE: 5 Gauzed wrapped 8 Saw cut 11 None (open hole)
 1 Continuous slot 3 Mill slot 6 Wire wrapped 9 Drilled holes
 2 Louvered shutter 4 Key punched 7 Torch cut 10 Other (specify) _____ ft.

SCREEN-PERFORATED INTERVALS: From _____ ft. to _____ ft., From _____ ft. to _____ ft.
 From _____ ft. to _____ ft., From _____ ft. to _____ ft.
 GRAVEL PACK INTERVALS: From _____ ft. to _____ ft., From _____ ft. to _____ ft.
 From _____ ft. to _____ ft., From _____ ft. to _____ ft.

6 GROUT MATERIAL: 1 Neat cement 2 Cement grout Bentonite 4 Other _____
 Grout Intervals: From 5 ft. to 2.00 ft., From _____ ft. to _____ ft., From _____ ft. to _____ ft.

What is the nearest source of possible contamination: 10 Livestock pens 14 Abandoned water well
 1 Septic tank 4 Lateral lines 7 Pit privy 11 Fuel storage 15 Oil well/Gas well
 2 Sewer lines 5 Cess pool 8 Sewage lagoon 12 Fertilizer storage Other (specify below)
 3 Watertight sewer lines 6 Seepage pit 9 Feedyard 13 Insecticide storage HOUSE

Direction from well? WEST How many feet? 22

FROM	TO	LITHOLOGIC LOG	FROM	TO	PLUGGING INTERVALS
0	5	SOIL	197	200	SHALE, GRAY
5	14	SANDY CLAY			
14	55	CLAY			
55	62	SAND W/ GRAVEL			
62	75	SHALE, GRAY			
75	76	LIMESTONE			
76	106	SHALE, GRAY			
106	107	LIMESTONE			
107	180	SHALE, GRAY			
180	182	LIMESTONE			
182	187	SHALE, GRAY			
187	188	LIMESTONE			
188	195	SHALE, GRAY			
195	197	LIMESTONE			

7 CONTRACTOR'S OR LANDOWNER'S CERTIFICATION: This reconstructed well was (1) constructed, (2) reconstructed, or (3) plugged under my jurisdiction and was completed on (mo/day/year) 2/8/06 and this record is true to the best of my knowledge and belief. Kansas Water Well Contractor's Licence No 760 This Water Well Record was completed on (mo/day/yr) 3/8/06 under the business name of ASSOCIATED DRILLING INC. by (signature) [Signature]