

1	LOCATION OF WATER WELL:	Fraction	Section Number	Township Number	Range Number
County: Osborne		NW¼ NE ¼ NW¼	20	7 S	12 EW


Distance and direction from nearest town or city street address of well if located within city?
435 E. Main, Osborne

2 WATER WELL OWNER: OSBORNE COUNTY HIGHWAY DEPT

RR #, St. Address, Box #: 435 E. Main
City, State, ZIP Code : Osborne, KS 67473

Board of Agriculture, Division of Water Resources
Application Number:

3 MARK WELL'S LOCATION WITH AN "X" IN SECTION BOX:

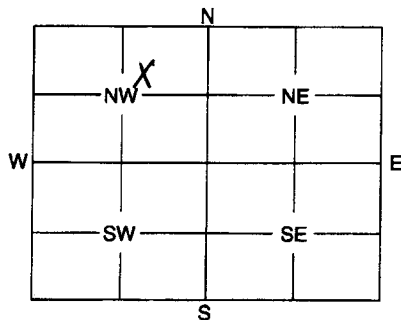

4 DEPTH OF WELL 28 ft.

WELL'S STATIC WATER LEVEL Dry ft.

WELL WAS USED AS:

- | | | |
|--------------|----------------------------|---|
| 1 Domestic | 5 Public Water Supply | 9 Dewatering |
| 2 Irrigation | 6 Oil Field Water Supply | 10 Monitoring Well |
| 3 Feedlot | 7 Domestic (Lawn & Garden) | 11 Injection Well |
| 4 Industrial | 8 Air Conditioning | <input checked="" type="checkbox"/> Other Soil vapor extraction |

Was a chemical / bacteriological sample submitted to Department? Yes No ☒
If yes, mo/day/yr sample was submitted

Water Well Disinfected: Yes No ☒

5 TYPE OF BLANK CASING USED:

- | | | | | |
|---|------------|-------------------|-----------------|-------------------------|
| 1 Steel | 3 RMP (SR) | 5 Wrought | 7 Fiberglass | 9 Other (Specify below) |
| <input checked="" type="checkbox"/> PVC | 4 ABS | 6 Asbestos-Cement | 8 Concrete Tile | |

Blank casing diameter 2 in. Was casing pulled? Yes No If yes, how much 3'
Casing height above or below land surface below in.

6 GROUT PLUG MATERIAL: 1 Neat cement 2 Cement grout ☒ Bentonite 4 Other

Grout Plug Intervals: From 3 ft. to 28 ft., From ft. to ft., From to ft.

What is the nearest source of possible contamination:

- | | | | |
|--------------------------|-------------------|-------------------------|--------------------------|
| 1 Septic tank | 6 Seepage pit | 11 Fuel storage | 16 Other (specify below) |
| 2 Sewer lines | 7 Pit privy | 12 Fertilizer storage | |
| 3 Watertight sewer lines | 8 Sewage lagoon | 13 Insecticide storage | |
| 4 Lateral lines | 9 Feedyard | 14 Abandoned water well | |
| 5 Cess pool | 10 Livestock pens | 15 Oil well/Gas well | |

Direction from well? How many feet?

FROM	TO	PLUGGING MATERIALS
3	28	Bentonite (2")

SVE3

KDHE #U6 071 00364

GeoCore #1105

7 CONTRACTOR'S OF LANDOWNER'S CERTIFICATION: This water well was plugged under my jurisdiction and was completed on (mo/day/year) 7/30/2007 and this record is true to the best of my knowledge and belief. Kansas Water Well Contractor's License No. 527 This Water Well Record was completed on (mo/day/year) 8/16/2007 under the business name of GeoCore Inc.
by (signature) *Don Bell*

INSTRUCTIONS: Use typewriter or ball point pen. Please press firmly and print clearly. Please fill in blanks, underline or circle the correct answers. Send top three copies to Kansas Department of Health and Environment, Bureau of Water, Geology Section, 1000 SW Jackson St., Ste. 420, Topeka, Kansas 66612-1367. Telephone: 785/296-5522. Send one to Water Well Owner and retain one for your records.