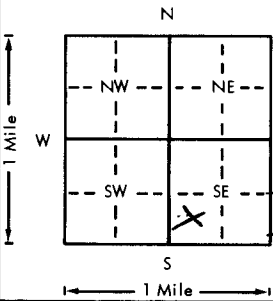
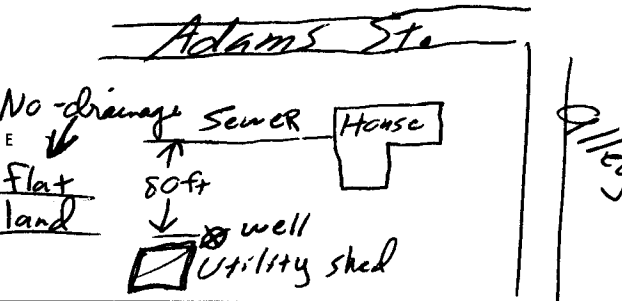


USE TYPEWRITER OR BALL POINT PEN-PRESS FIRMLY, PRINT CLEARLY.

WATER WELL RECORD
KSA 82a-1201-1215

Kansas Department of Health and Environment-Division of Environment (Water well Contractors) Topeka, Kansas 66620

1. Location of well:	County OSBORNE	Fraction 1/4 SW 1/4 SE 1/4	Section number 18	Township number T 7 S R 12 E/W	Range number
2. Distance and direction from nearest town or city:	IN OSBORNE		3. Owner of well:	RICHARD SCHURR	
Street address of well location if in city:	West Adams St.		R.R. or street:	West Adams St.	
			City, state, zip code:	OSBORNE, KANSAS - 67473	
4. Locate with "X" in section below:	Sketch map:		6. Bore hole dia. 4 1/2 in.	Completion date 3-27-77	
			Well depth 40 ft.		
			7. <input checked="" type="checkbox"/> Cable tool <input checked="" type="checkbox"/> Rotary <input type="checkbox"/> Driven <input type="checkbox"/> Dug		
			<input type="checkbox"/> Hollow rod <input type="checkbox"/> Jetted <input type="checkbox"/> Bored <input type="checkbox"/> Reverse rotary		
			8. Use: <input type="checkbox"/> Domestic <input type="checkbox"/> Public supply <input type="checkbox"/> Industry		
			<input type="checkbox"/> Irrigation <input type="checkbox"/> Air conditioning <input type="checkbox"/> Stock		
			<input checked="" type="checkbox"/> Lawn <input type="checkbox"/> Oil field water <input type="checkbox"/> Other		
5. Type and color of material	From	To	9. Casing: Material plastic	Height: Above or below	
top soil - Rich black dirt	0	2	Threaded <input type="checkbox"/> Welded <input checked="" type="checkbox"/> galv	Surface 1 1/2 in.	
clay light brown	2	23	RMP <input type="checkbox"/> PVC <input checked="" type="checkbox"/>	Weight <input type="checkbox"/> lbs./ft.	
clay light brown mixed with fine sand	23	29	Dia. 1 1/2 in. to 40 ft. depth	Wall Thickness: inches or	
sand medium to 1/8" dia.	29	34	Dia. <input type="checkbox"/> in. to <input type="checkbox"/> ft. depth	gage No. 3/16	
1/8" dia. to 1/2" dia. sand + Rocks	34	40	10. Screen: Manufacturer's name Jess and Lowell Superior Well Casing		
			Type 100 PVC	Dia. 6 inch	
			Slot/gauze 1/16	Length 16	
			Set between 30 ft. and 40 ft.		
			Gravel pack? yes	Size range of material 1/8" to 1/4"	
			11. Static water level: 29 ft. below land surface	Date 3-27-77	
			12. Pumping level below land surfaces:		
			29 ft. after 8 hrs. pumping	12 g.p.m.	
			Estimated maximum yield 40-45	g.p.m.	
			13. Water sample submitted: <input checked="" type="checkbox"/> Yes <input type="checkbox"/> No	Date	
			14. Well head completion: 18 inches above grade		
			15. Well grouted? yes		
			With: <input type="checkbox"/> Neat cement <input type="checkbox"/> Bentonite <input checked="" type="checkbox"/> Concrete		
			Depth: From 0 ft. to 10 ft.		
			16. Nearest source of possible contamination: SOFT		
			ft. 100 Direction North Type Sewer line		
			Well disinfected upon completion? <input checked="" type="checkbox"/> Yes <input type="checkbox"/> No		
			17. Pump: <input checked="" type="checkbox"/> Not installed		
			Manufacturer's name		
			Model number	HP Volts	
			Length of drop pipe	ft. capacity g.p.m.	
			Type:		
			<input type="checkbox"/> Submersible <input type="checkbox"/> Turbine		
			<input type="checkbox"/> Jet <input type="checkbox"/> Reciprocating		
			<input type="checkbox"/> Centrifugal <input type="checkbox"/> Other		
18. Elevation:	19. Remarks:		20. Water well contractor's certification:		
Flat land			This well was drilled under my jurisdiction and this report is true to the best of my knowledge and belief.		
Topography:			Business name Schurr Drilling License No. 348		
<input type="checkbox"/> Hill			Address W. Cas St. Osborne, Kans		
<input type="checkbox"/> Slope			Signed Mike Schurr Date 4-18-77		
<input type="checkbox"/> Upland			Authorized representative		
<input type="checkbox"/> Valley					

- 2
 120
 18
 1/4 SW SE
 1/4
 2/4