


1 LOCATION OF WATER WELL: Fraction SE 1/4 SE 1/4 SE 1/4 Section Number 18 Township Number T 7 S Range Number R 12 EW  
 County: OSBORNE

Distance and direction from nearest town or city street address of well if located within city?  
221 W Madison Osborne KS 67423

2 WATER WELL OWNER: Dell Princ  
 RR#, St. Address, Box #: 221 W Madison Board of Agriculture, Division of Water Resources  
 City, State, ZIP Code: Osborne KS Application Number:

3 LOCATE WELL'S LOCATION WITH AN "X" IN SECTION BOX:

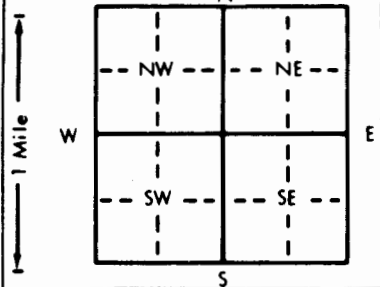

4 DEPTH OF COMPLETED WELL: 48 ft. ELEVATION:  
 Depth(s) Groundwater Encountered 1. 37.5 ft. 2. ft. 3. ft.  
 WELL'S STATIC WATER LEVEL: 37.5 ft. below land surface measured on mo/day/yr 5-13-91  
 Pump test data: Well water was 38 ft. after 1 hours pumping 8 gpm  
 Est. Yield 15+ gpm: Well water was ft. after hours pumping gpm  
 Bore Hole Diameter: 9 in. to 48 ft., and in. to ft.  
 WELL WATER TO BE USED AS:  
 5 Public water supply 8 Air conditioning 11 Injection well  
 1 Domestic 3 Feedlot 6 Oil field water supply 9 Dewatering 12 Other (Specify below)  
 2 Irrigation 4 Industrial 7 Lawn and garden only 10 Monitoring well  
 Was a chemical/bacteriological sample submitted to Department? Yes No X; If yes, mo/day/yr sample was submitted  
 Water Well Disinfected? Yes X No

5 TYPE OF BLANK CASING USED:  
 1 Steel 3 RMP (SR) 5 Wrought iron 8 Concrete tile CASING JOINTS: Glued X Clamped  
2 PVC 4 ABS 6 Asbestos-Cement 9 Other (specify below) Welded  
 7 Fiberglass Threaded

Blank casing diameter: 6 in. to 35 ft. Dia. in. to ft. Dia. in. to ft.  
 Casing height above land surface: 24 in., weight 325 cft lbs./ft. Wall thickness or gauge No. 255

TYPE OF SCREEN OR PERFORATION MATERIAL:  
 1 Steel 3 Stainless steel 5 Fiberglass 7 PVC 10 Asbestos-cement  
 2 Brass 4 Galvanized steel 6 Concrete tile 9 ABS 11 Other (specify)  
 12 None used (open hole)

SCREEN OR PERFORATION OPENINGS ARE:  
 1 Continuous slot 3 Mill slot 5 Gauzed wrapped 8 Saw cut 11 None (open hole)  
 2 Louvered shutter 4 Key punched 6 Wire wrapped 9 Drilled holes  
 7 Torch cut 10 Other (specify)

SCREEN-PERFORATED INTERVALS: From 35 ft. to 45 ft., From ft. to ft.  
 From ft. to ft., From ft. to ft.  
 GRAVEL PACK INTERVALS: From 2.0 ft. to 48 ft., From ft. to ft.  
 From ft. to ft., From ft. to ft.

6 GROUT MATERIAL: 1 Neat cement 2 Cement grout 3 Bentonite 4 Other Hole Plug  
 Grout intervals: From 0 ft. to 20 ft., From ft. to ft., From ft. to ft.

What is the nearest source of possible contamination:  
 1 Septic tank 4 Lateral lines 7 Pit privy 10 Livestock pens 14 Abandoned water well  
2 Sewer lines 5 Cess pool 8 Sewage lagoon 11 Fuel storage 15 Oil well/Gas well  
3 Watertight sewer lines 6 Seepage pit 9 Feedyard 12 Fertilizer storage 16 Other (specify below)  
 13 Insecticide storage  
 Direction from well? N How many feet? 75+

FROM	TO	LITHOLOGIC LOG	FROM	TO	PLUGGING INTERVALS
0	31	Top soil & clay			
31	35	Sand med to coarse			
35	43	sand coarse to small gravel & small broken rock			
43	48	Shale			

7 CONTRACTOR'S OR LANDOWNER'S CERTIFICATION: This water well was 0 constructed, (2) reconstructed, or (3) plugged under my jurisdiction and was completed on (mo/day/year) 5-13-91 and this record is true to the best of my knowledge and belief. Kansas Water Well Contractor's License No. 165 This Water Well Record was completed on (mo/day/yr) 5-16-91 under the business name of MARUHN well Drilling by signature Lucy Maruhn