


1 LOCATION OF WATER WELL: Fraction NW 1/4 NE 1/4 NW 1/4 Section Number 20 Township Number T 7 S Range Number R 12 E 10

County: Osborne Distance and direction from nearest town or city street address of well if located within city? East Main Street, Osborne, Ks. MW 9

2 WATER WELL OWNER: Osborne County Highway Dept. RR#, St. Address, Box #: P.O. Box 347 Board of Agriculture, Division of Water Resources City, State, ZIP Code: Osborne, Ks. 67473 Application Number:

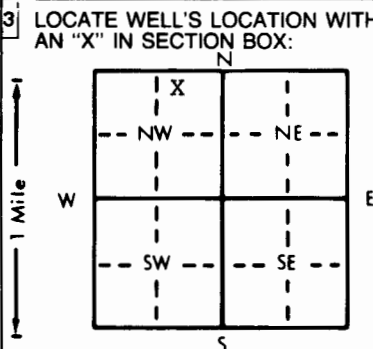

4 DEPTH OF COMPLETED WELL: 40 ft. ELEVATION: WELL'S STATIC WATER LEVEL: 30.87 ft. below land surface measured on mo/day/yr 6-10-91. Pump test data: Well water was ... ft. after ... hours pumping ... gpm. Est. Yield ... gpm: Well water was ... ft. after ... hours pumping ... gpm. Bore Hole Diameter: 7 5/8 in. to 40 ft., and ... in. to ... ft. WELL WATER TO BE USED AS: 5 Public water supply 8 Air conditioning 11 Injection well 1 Domestic 3 Feedlot 6 Oil field water supply 9 Dewatering 12 Other (Specify below) 2 Irrigation 4 Industrial 7 Lawn and garden only 10 Monitoring well. Was a chemical/bacteriological sample submitted to Department? Yes ... No X. If yes, mo/day/yr sample was submitted. Water Well Disinfected? Yes No X

5 TYPE OF BLANK CASING USED: 1 Steel 3 RMP (SR) 5 Wrought iron 8 Concrete tile CASING JOINTS: Glued ... Clamped ... 2 PVC 4 ABS 6 Asbestos-Cement 9 Other (specify below) Welded ... Threaded ... Blank casing diameter ... 2 in. to 17.5 ft., Dia ... in. to ... ft., Dia ... in. to ... ft. Casing height above land surface ... 0 in., weight ... lbs./ft. Wall thickness or gauge No. Schedule 40. TYPE OF SCREEN OR PERFORATION MATERIAL: 1 Steel 3 Stainless steel 5 Fiberglass 8 RMP (SR) 10 Asbestos-cement 11 Other (specify) ... 2 Brass 4 Galvanized steel 6 Concrete tile 9 ABS 12 None used (open hole). SCREEN OR PERFORATION OPENINGS ARE: 1 Continuous slot 3 Mill slot 5 Gauzed wrapped 8 Saw cut 11 None (open hole) 2 Louvered shutter 4 Key punched 6 Wire wrapped 9 Drilled holes 10 Other (specify) ... SCREEN-PERFORATED INTERVALS: From 17.5 ft. to 37.5 ft., From ... ft. to ... ft. GRAVEL PACK INTERVALS: From 15 ft. to 37.5 ft., From ... ft. to ... ft.

6 GROUT MATERIAL: 1 Neat cement 2 Cement grout 3 Bentonite 4 Other Grout Intervals: From 0 ft. to 11 (2) ft., From 11 ft. to 15 (3) ft., From ... ft. to ... ft. What is the nearest source of possible contamination: 1 Septic tank 4 Lateral lines 7 Pit privy 10 Livestock pens 14 Abandoned water well 2 Sewer lines 5 Cess pool 8 Sewage lagoon 11 Fuel storage 15 Oil well/Gas well 3 Watertight sewer lines 6 Seepage pit 9 Feedyard 12 Fertilizer storage 16 Other (specify below) 13 Insecticide storage Direction from well? North How many feet? 230

FROM	TO	LITHOLOGIC LOG	FROM	TO	PLUGGING INTERVALS
0	1"	Asphalt			
1"	7	Clay, Black to Brown, Silty			
7	17	Clay, Yellow Brown, Silty			
17	21	Silt, Yellow Brown, Sandy to Clayey			
21	24	Sand, Yellow Brown, Silty			
24	40	Sand, White Medium to Coarse			

7 CONTRACTOR'S OR LANDOWNER'S CERTIFICATION: This water well was 1 constructed, (2) reconstructed, or (3) plugged under my jurisdiction and was completed on (mo/day/year) 6-11-91 and this record is true to the best of my knowledge and belief. Kansas Water Well Contractor's License No. 527. This Water Well Record was completed on (mo/day/yr) 6-25-91 under the business name of GeoCore Services, Inc. by (signature) Dale A. Poff

INSTRUCTIONS: Use typewriter or ball point pen. PLEASE PRESS FIRMLY and PRINT clearly. Please fill in blanks, underline or circle the correct answers. Send top three copies to Kansas Department of Health and Environment, Bureau of Water, Topeka, Kansas 66620-7320. Telephone: 913-296-5545. Send one to WATER WELL OWNER and retain one for your records.