


1 LOCATION OF WATER WELL: Fraction NW 1/4 NE 1/4 NW 1/4 Section Number 20 Township Number T 7 S Range Number R 12 EW

Distance and direction from nearest town or city street address of well if located within city?  
 East Main Street, Osborne, Ks. MW 10

2 WATER WELL OWNER: Osborne County Highway Dept.  
 RR#, St. Address, Box #: P.O. Box 347 Board of Agriculture, Division of Water Resources  
 City, State, ZIP Code: Osborne, Ks 67473 Application Number:

3 LOCATE WELL'S LOCATION WITH AN "X" IN SECTION BOX:

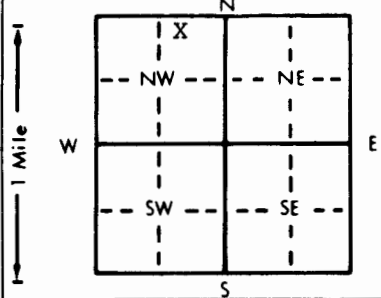

4 DEPTH OF COMPLETED WELL: 35 ft. ELEVATION:  
 Depth(s) Groundwater Encountered 1. 30.94 ft. 2. ft. 3. ft.  
 WELL'S STATIC WATER LEVEL: 30.94 ft. below land surface measured on mo/day/yr 6-10-91  
 Pump test data: Well water was ft. after hours pumping gpm  
 Est. Yield gpm: Well water was ft. after hours pumping gpm  
 Bore Hole Diameter: 7 5/8 in. to 35 ft., and in. to ft.  
 WELL WATER TO BE USED AS:  
 5 Public water supply 8 Air conditioning 11 Injection well  
 1 Domestic 3 Feedlot 6 Oil field water supply 9 Dewatering 12 Other (Specify below)  
 2 Irrigation 4 Industrial 7 Lawn and garden only 13 Monitoring well  
 Was a chemical/bacteriological sample submitted to Department? Yes No X; If yes, mo/day/yr sample was submitted  
 Water Well Disinfected? Yes No X

5 TYPE OF BLANK CASING USED:  
 1 Steel 3 RMP (SR) 5 Wrought iron 8 Concrete tile CASING JOINTS: Glued Clamped  
 2 PVC 4 ABS 6 Asbestos-Cement 9 Other (specify below) Welded  
 7 Fiberglass Threaded X  
 Blank casing diameter 2 in. to 25 ft., Dia in. to ft., Dia in. to ft.  
 Casing height above land surface 0 in., weight lbs./ft. Wall thickness or gauge No. Schedule 40  
 TYPE OF SCREEN OR PERFORATION MATERIAL:  
 1 Steel 3 Stainless steel 5 Fiberglass 8 RMP (SR) 10 Asbestos-cement  
 2 Brass 4 Galvanized steel 6 Concrete tile 9 ABS 11 Other (specify)  
 12 None used (open hole)  
 SCREEN OR PERFORATION OPENINGS ARE:  
 1 Continuous slot 3 Mill slot 5 Gauzed wrapped 8 Saw cut 11 None (open hole)  
 2 Louvered shutter 4 Key punched 6 Wire wrapped 9 Drilled holes  
 7 Torch cut 10 Other (specify)  
 SCREEN-PERFORATED INTERVALS: From 25 ft. to 35 ft., From ft. to ft.  
 GRAVEL PACK INTERVALS: From 23 ft. to 35 ft., From ft. to ft.

6 GROUT MATERIAL: 1 Neat cement 2 Cement grout 3 Bentonite 4 Other  
 Grout Intervals: From 0 ft. to 19 (2) ft., From 19 ft. to 23 (3) ft., From ft. to ft.  
 What is the nearest source of possible contamination:  
 1 Septic tank 4 Lateral lines 7 Pit privy 11 Fuel storage 14 Abandoned water well  
 2 Sewer lines 5 Cess pool 8 Sewage lagoon 12 Fertilizer storage 15 Oil well/Gas well  
 3 Watertight sewer lines 6 Seepage pit 9 Feedyard 13 Insecticide storage 16 Other (specify below)

Direction from well? Northeast How many feet? 80'

FROM	TO	LITHOLOGIC LOG	FROM	TO	PLUGGING INTERVALS
0	14	Clay, Yellow Brown, Silty			
14	17	Silt, Yellow Brown, Sandy			
17	21	Sand, Yellow Brown, Medium to Coarse			
21	23	Sand, Greyish Brown, Fine to Medium, Silty			
23	30	Silt, Greyish Brown, Sandy, Clayey			
30	35	Sand, Greyish Brown, Medium to Coarse			

7 CONTRACTOR'S OR LANDOWNER'S CERTIFICATION: This water well was 1 constructed, 2 reconstructed, or 3 plugged under my jurisdiction and was completed on (mo/day/year) 6-11-91 and this record is true to the best of my knowledge and belief. Kansas Water Well Contractor's License No. 527 This Water Well Record was completed on (mo/day/yr) 6-25-91 under the business name of GeoCore Services, Inc. by (signature) Dan A. Rott