


1 LOCATION OF WATER WELL: Fraction NW 1/4 NE 1/4 NW 1/4 Section Number 20 Township Number T 7 S Range Number R 12 EW

Distance and direction from nearest town or city street address of well if located within city?
 Osborne County Shop, East Main Street, Osborne, Ks.

2 WATER WELL OWNER: Osborne County Highway Department
 RR#, St. Address, Box #: P.O. Box 347 Board of Agriculture, Division of Water Resources
 City, State, ZIP Code: Osborne, Ks. 67473 Application Number:

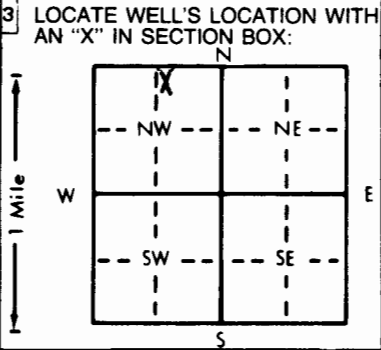

4 DEPTH OF COMPLETED WELL: 53 ft. ELEVATION: ... ft.
 Depth(s) Groundwater Encountered 1. 31 ft. 2. ... ft. 3. ... ft.
 WELL'S STATIC WATER LEVEL: 30.67 ft. below land surface measured on mo/day/yr 06-18-92
 Pump test data: Well water was 32.72 ft. after 1 hours pumping ... gpm
 Est. Yield: 50 gpm: Well water was 33.15 ft. after 24 hours pumping ... gpm
 Bore Hole Diameter: 12 in. to 54 ft., and ... in. to ... ft.
 WELL WATER TO BE USED AS:
 5 Public water supply 8 Air conditioning 11 Injection well
 1 Domestic 3 Feedlot 6 Oil field water supply 9 Dewatering 12 Other (Specify below) pump test, monitor
 2 Irrigation 4 Industrial 7 Lawn and garden only 10 Monitoring well
 Was a chemical/bacteriological sample submitted to Department? Yes... No... xx; If yes, mo/day/yr sample was submitted
 Water Well Disinfected? Yes No xx

5 TYPE OF BLANK CASING USED:
 1 Steel 3 RMP (SR) 5 Wrought iron 8 Concrete tile CASING JOINTS: Glued ... Clamped ...
2 PVC 4 ABS 6 Asbestos-Cement 9 Other (specify below) Welded ...
 7 Fiberglass Threaded... xx
 Blank casing diameter: 4 in. to 23 ft., Dia. ... in. to ... ft., Dia. ... in. to ... ft.
 Casing height above land surface: 0 in., weight ... lbs./ft. Wall thickness or gauge No. Sch. 40
 TYPE OF SCREEN OR PERFORATION MATERIAL:
 1 Steel 3 Stainless steel 5 Fiberglass 7 PVC 8 RMP (SR) 10 Asbestos-cement
 2 Brass 4 Galvanized steel 6 Concrete tile 9 ABS 11 Other (specify) ...
 12 None used (open hole)
 SCREEN OR PERFORATION OPENINGS ARE:
 1 Continuous slot 3 Mill slot .040 5 Gauzed wrapped 8 Saw cut 11 None (open hole)
 2 Louvered shutter 4 Key punched 6 Wire wrapped 9 Drilled holes
 7 Torch cut 10 Other (specify) ...
 SCREEN-PERFORATED INTERVALS: From 53 ft. to 23 ft., From ... ft. to ... ft.
 GRAVEL PACK INTERVALS: From 54 ft. to 20 ft., From ... ft. to ... ft.

6 GROUT MATERIAL: 1 Neat cement 2 Cement grout 3 Bentonite 4 Other
 Grout Intervals: From 20 ft. to 18 ft., From 18 ft. to 0 ft., From ... ft. to ... ft.
 What is the nearest source of possible contamination:
 1 Septic tank 4 Lateral lines 7 Pit privy 10 Livestock pens 14 Abandoned water well
 2 Sewer lines 5 Cess pool 8 Sewage lagoon 11 Fuel storage 15 Oil well/Gas well
 3 Watertight sewer lines 6 Seepage pit 9 Feedyard 12 Fertilizer storage 16 Other (specify below)
 13 Insecticide storage
 Direction from well? NW How many feet? 200

FROM	TO	LITHOLOGIC LOG	FROM	TO	PLUGGING INTERVALS
0	5	Clay - black			KDHE Tag # 93095
5	10	Clay - brown			MW 15
10	23	Clay - light brown			Completed in drive area with flush
23	53	Sand - gravel			mounted well cover
53	54	Shale			

7 CONTRACTOR'S OR LANDOWNER'S CERTIFICATION: This water well was (1) constructed (2) reconstructed, or (3) plugged under my jurisdiction and was completed on (mo/day/year) 05-29-92 and this record is true to the best of my knowledge and belief. Kansas Water Well Contractor's License No. 527 This Water Well Record was completed on (mo/day/yr) 07-27-92 under the business name of GeoCore Services, Inc. by (signature) Dale A. Kohl