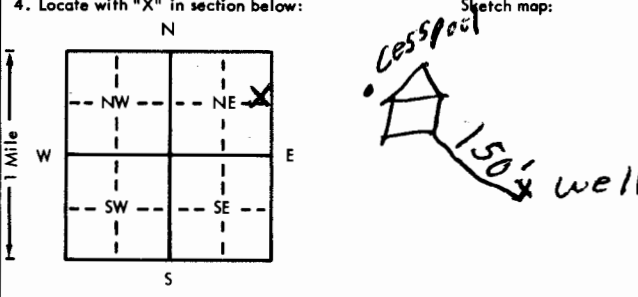


USE TYPEWRITER OR BALL
POINT PEN-PRESS FIRMLY,
PRINT CLEARLY.

WATER WELL RECORD
KSA 82a-1201-1215

Kansas Department of Health and
Environment-Division of Environment
(Water well Contractors)
Topeka, Kansas 66620

1. Location of well:	County OSBORNE	Fraction SE 1/4 NE 1/4 NE 1/4	Section number 30	Township number T 7 S	Range number R 12 E
2. Distance and direction from nearest town or city: 1/2 mile south of OSBORNE, Kan.		3. Owner of well: Raymond Newman R.R. or street: R.R. City, state, zip code: OSBORNE, KANSAS			
4. Locate with "X" in section below: 		6. Bore hole dia. 9 in. Completion date 3-15-77 Well depth 53 ft.			
5. Type and color of material		7. <input checked="" type="checkbox"/> Cable tool <input checked="" type="checkbox"/> Rotary <input type="checkbox"/> Driven <input type="checkbox"/> Dug <input type="checkbox"/> Hollow rod <input type="checkbox"/> Jetted <input type="checkbox"/> Bored <input type="checkbox"/> Reverse rotary			
TOP SOIL		8. Use: <input checked="" type="checkbox"/> Domestic <input type="checkbox"/> Public supply <input type="checkbox"/> Industry <input type="checkbox"/> Irrigation <input type="checkbox"/> Air conditioning <input type="checkbox"/> Stock <input type="checkbox"/> Lawn <input type="checkbox"/> Oil field water <input type="checkbox"/> Other			
Silty BROWN clay		9. Casing: Material CORRO Height Above or below Threaded WELDED Surface 2 ft. in.			
sand lined, gravel		RMP <input checked="" type="checkbox"/> PVC <input type="checkbox"/> Weight 16 lbs./ft.			
shale		Dia. 5 in. to 53 ft. depth Wall Thickness: inches or Dia. 5 in. to 53 ft. depth gage No. 250			
		10. Screen: Manufacturer's name JESS 2 Howell Type plastic RMP Dia. 5" Slot/gauze 1/16" Length 10' Set between 43 ft. and 53 ft. Gravel pack? yes Size range of material 1/4 to 1/2"			
		11. Static water level: 43 mo./day/yr. 43 ft. below land surface Date 3-15-77			
		12. Pumping level below land surfaces: NA ft. after NA hrs. pumping NA g.p.m. ft. after NA hrs. pumping NA g.p.m. Estimated maximum yield NA g.p.m.			
		13. Water sample submitted: NA mo./day/yr. Yes <input checked="" type="checkbox"/> No <input type="checkbox"/> Date NA			
		14. Well head completion: NA Pitless adapter NA inches above grade			
		15. Well grouted? yes With: <input checked="" type="checkbox"/> Neat cement <input checked="" type="checkbox"/> Bentonite <input type="checkbox"/> Concrete Depth: From 5 ft. to 10 ft.			
		16. Nearest source of possible contamination: cess ft. 156 Direction NW Type pool Well disinfected upon completion? <input checked="" type="checkbox"/> Yes <input type="checkbox"/> No			
		17. Pump: <input checked="" type="checkbox"/> Not installed Manufacturer's name NA Model number NA HP NA Volts NA Length of drop pipe NA ft. capacity NA g.p.m. Type: <input type="checkbox"/> Submersible <input type="checkbox"/> Turbine <input type="checkbox"/> Jet <input type="checkbox"/> Reciprocating <input type="checkbox"/> Centrifugal <input type="checkbox"/> Other			
18. Elevation:		20. Water well contractor's certification: This well was drilled under my jurisdiction and this report is true to the best of my knowledge and belief. OIL DRILLING CO 303 Business name License No. Address HILL CITY, KANSAS Signed Allen D. ... Date 3-21-77 Authorized representative			
19. Remarks:					

Forward the white, blue and pink copies to the Department of Health and Environment

Form WWC-5