


WATER WELL RECORD Form WWC-5 KSA 82a-1212

1 LOCATION OF WATER WELL: County: Osborne Fraction SE 1/4 NE 1/4 NE 1/4 Section Number 18 Township Number T 7 S Range Number R 12 E/W

Distance and direction from nearest town or city street address of well if located within city? 707 N. First, Osborne, Kansas

2 WATER WELL OWNER: Midway Coop Association, Inc. RR#, St. Address, Box #: P.O. Box 40 City, State, ZIP Code: Osborne, Kansas 67473 Board of Agriculture, Division of Water Resources Application Number:

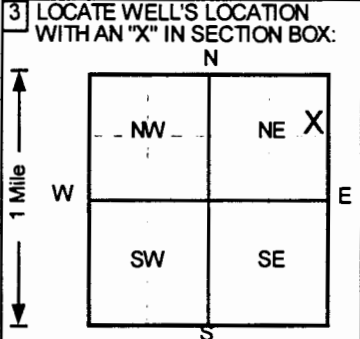

4 DEPTH OF COMPLETED WELL: 43 ft. ELEVATION: 1569.92. WELL'S STATIC WATER LEVEL: 41.55 ft. below land surface measured on 2/3/98. Pump test data: Well water was NA ft. after NA hours pumping NA gpm. Est. Yield: NA gpm. Bore Hole Diameter: 8 in. to 43 ft. WELL WATER TO BE USED AS: 10 Monitoring well. Was a chemical/bacteriological sample submitted? No. Water Well Disinfected? No.

5 TYPE OF BLANK CASING USED: 2 PVC. Blank casing diameter: 2 in. to 28 ft. Dia. Casing height above land surface: 29.76 in., weight: Sch 40 lbs./ft. TYPE OF SCREEN OR PERFORATION MATERIAL: 7 PVC. SCREEN OR PERFORATION OPENINGS ARE: 3 Mill slot. SCREEN-PERFORATED INTERVALS: From 28 ft to 43 ft. GRAVEL PACK INTERVALS: From 26 ft to 43 ft.

6 GROUT MATERIAL: 2 Cement grout, 3 Bentonite. Grout Intervals: From 0 ft to 22 ft, From 22 ft to 26 ft. What is the nearest source of possible contamination: 16 Other (specify below) Former Tank Basin. Direction from well? South. How many feet? 150

Table with columns: FROM, TO, LITHOLOGIC LOG, FROM, TO, PLUGGING INTERVALS. Rows show lithology: Clay, Brown (0-4, 4-34, 34-40) and Silt, Light Brown (40-43). Plug intervals: MW3, Tag # 00191661, Abovegrade; Project Name: Midway Coop Association, Inc - Osborne; GeoCore # 567, KDHE # U6 071 11162.

7 CONTRACTOR'S OR LANDOWNER'S CERTIFICATION: This water well was (1) constructed, (2) reconstructed, or (3) plugged under my jurisdiction and was completed on (mo/day/year) 12/30/97 and this record is true to the best of my knowledge and belief. Kansas Water Well Contractor's License No. 527. This Water Well Record was completed on (mo/day/yr) 2/3/98 under the business name of GeoCore Services, Inc. by (signature) Dan Roll

INSTRUCTIONS: Use typewriter or ball point pen. PLEASE PRESS FIRMLY and PRINT clearly. Please fill in blanks, underline or circle the correct answers. Send top three copies to Kansas Department of Health and Environment, Bureau of Water, Topeka, Kansas 66620-0001. Telephone: 913-296-5545. Send one to WATER WELL OWNER and retain one for your records.

OFFICE USE ONLY T R EW SEC