


1 LOCATION OF WATER WELL:	Fraction	Section Number	Township Number	Range Number
County: Osborne	NW 1/4 SW 1/4 SE 1/4	13	T 7 S	R 13 E/W

Distance and direction from nearest town or city street address of well if located within city?

Approximately 1/4 mile west of Osborne

2 WATER WELL OWNER:	Osborne, City of c/o City Clerk 133 West Main Osborne, KS 67473	Board of Agriculture, Division of Water Resources Application Number: 37,012
---------------------	--	---

3 LOCATE WELL'S LOCATION WITH AN "X" IN SECTION BOX:

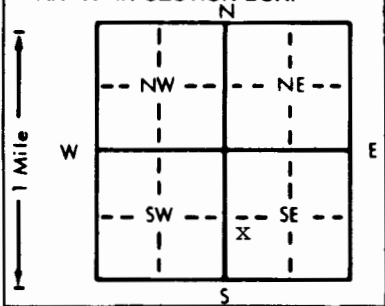

4 DEPTH OF COMPLETED WELL: 70 ft.	ELEVATION: unknown
Depth(s) Groundwater Encountered 1. ft. 2. ft. 3. ft.	
WELL'S STATIC WATER LEVEL: 36 ft. below land surface measured on mo/day/yr 9-3-91	
Pump test data: Well water was not ch'd. ft. after hours pumping gpm	
Est. Yield unknown gpm: Well water was ft. after hours pumping gpm	
Bore Hole Diameter: 18 in. to 69 in. and in. to ft.	
WELL WATER TO BE USED AS:	
5 Public water supply	8 Air conditioning
1 Domestic	3 Feedlot
2 Irrigation	4 Industrial
6 Oil field water supply	9 Dewatering
7 Lawn and garden only	10 Monitoring well
11 Injection well	12 Other (Specify below)
Was a chemical/bacteriological sample submitted to Department? Yes.....No...X.....; If yes, mo/day/yr sample was submitted	
Drilled near existing well Water Well Disinfected? Yes X No	

5 TYPE OF BLANK CASING USED:	5 Wrought iron	8 Concrete tile	CASING JOINTS: Glued .X. Clamped
1 Steel	3 RMP (SR)	6 Asbestos-Cement	9 Other (specify below)
2 PVC	4 ABS	7 Fiberglass	10 Welded
Blank casing diameter: 8 in. to 57 ft., Dia 8 in. to 69 ft., Dia			11 Threaded
Casing height above land surface: 12 in., weight 5.54 lbs./ft. Wall thickness or gauge No. 322			

TYPE OF SCREEN OR PERFORATION MATERIAL:	7 PVC	10 Asbestos-cement
1 Steel	3 Stainless steel	5 Fiberglass
2 Brass	4 Galvanized steel	6 Concrete tile
		7 RMP (SR)
		8 ABS
		9 Other (specify)
		12 None used (open hole)

SCREEN OR PERFORATION OPENINGS ARE:	5 Gauzed wrapped	8 Saw cut
1 Continuous slot	3 Mill slot	6 Wire wrapped
2 Louvered shutter	4 Key punched	7 Torch cut
		8 Saw cut
		9 Drilled holes
		10 Other (specify)
		11 None (open hole)

SCREEN-PERFORATED INTERVALS:	From 57 ft. to 65 ft., From ft. to ft.	From ft. to ft., From ft. to ft.
GRAVEL PACK INTERVALS:	From 45 ft. to 69 ft., From ft. to ft.	From ft. to ft., From ft. to ft.

6 GROUT MATERIAL:	1 Neat cement	2 Cement grout	Dirt	3 Bentonite	4 Other Bentonite	Holeplug and Sand
Grout Intervals: From 5 ft. to 25 ft., From 0 ft. to 5 ft., From 25 ft. to 45 ft.						
What is the nearest source of possible contamination:						
1 Septic tank	4 Lateral lines	7 Pit privy	10 Livestock pens	14 Abandoned water well		
2 Sewer lines	5 Cess pool	8 Sewage lagoon	11 Fuel storage	15 Oil well/Gas well		
3 Watertight sewer lines	6 Seepage pit	9 Feedyard	12 Fertilizer storage	16 Other (specify below)		
			13 Insecticide storage	None known		

Direction from well?		LITHOLOGIC LOG	How many feet?		PLUGGING INTERVALS
FROM	TO		FROM	TO	
0	3	Topsoil, clay, silty			
3	37	Clay, brown, soft			
37	57	Clay, blue			
57	65	Sand and gravel, fine, medium, clay			
		blue streak at 60'			
65	69	Shale, black			

7 CONTRACTOR'S OR LANDOWNER'S CERTIFICATION: This water well was (1) constructed, (2) reconstructed, or (3) plugged under my jurisdiction and was completed on (mo/day/year) 9-3-91 and this record is true to the best of my knowledge and belief. Kansas Water Well Contractor's License No. 185 This Water Well Record was completed on (mo/day/yr) 9-25-91 under the business name of Clarke Well & Equipment, Inc. by (signature) <i>Robert Clark</i>
--

INSTRUCTIONS: Use typewriter or ball point pen. PLEASE PRESS FIRMLY and PRINT clearly. Please fill in blanks, underline or circle the correct answers. Send top three copies to Kansas Department of Health and Environment, Bureau of Water, Topeka, Kansas 66620-0001. Telephone: 913-296-5545. Send one to WATER WELL OWNER and retain one for your records.