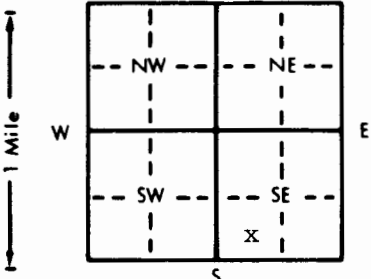


1 LOCATION OF WATER WELL: County: Osborne Fraction NE 1/4 SW 1/4 SE 1/4 Section Number 13 Township Number T 7 S Range Number R 13 EW

Distance and direction from nearest town or city street address of well if located within city?

Approximately 1/4 mile west of Osborne

2 WATER WELL OWNER: Osborne, City of c/o City Clerk 133 West Main Osborne, KS 67473 Board of Agriculture, Division of Water Resources Application Number: 37,012

3 LOCATE WELL'S LOCATION WITH AN "X" IN SECTION BOX:  4 DEPTH OF COMPLETED WELL: 69 ft. ELEVATION: unknown
 Depth(s) Groundwater Encountered 1. ... ft. 2. ... ft. 3. ... ft.
 WELL'S STATIC WATER LEVEL: .37 ft. below land surface measured on mo/day/yr 9-4-91
 Pump test data: Well water was not ch'd ft. after ... hours pumping ... gpm
 Est. Yield unknown gpm: Well water was ... ft. after ... hours pumping ... gpm
 Bore Hole Diameter: .18 in. to .68 ft., and ... in. to ... ft.
 WELL WATER TO BE USED AS: 5 Public water supply 8 Air conditioning 11 Injection well
 1 Domestic 3 Feedlot 6 Oil field water supply 9 Dewatering 12 Other (Specify below)
 2 Irrigation 4 Industrial 7 Lawn and garden only 10 Monitoring well
 Was a chemical/bacteriological sample submitted to Department? Yes ... No x ...; If yes, mo/day/yr sample was submitted Drilled near existing well Water Well Disinfected? Yes x No

5 TYPE OF BLANK CASING USED: 5 Wrought iron 8 Concrete tile CASING JOINTS: Glued x Clamped
 1 Steel 3 RMP (SR) 6 Asbestos-Cement 9 Other (specify below) Welded
 2 PVC 4 ABS 7 Fiberglass Threaded
 Blank casing diameter: .8 in. to .54 ft., Dia .8 in. to .68 ft., Dia ... in. to ... ft.
 Casing height above land surface: .12 in., weight 5.54 lbs./ft. Wall thickness or gauge No. .322
 TYPE OF SCREEN OR PERFORATION MATERIAL: 7 PVC 10 Asbestos-cement
 1 Steel 3 Stainless steel 5 Fiberglass 8 RMP (SR) 11 Other (specify)
 2 Brass 4 Galvanized steel 6 Concrete tile 9 ABS 12 None used (open hole)
 SCREEN OR PERFORATION OPENINGS ARE: 5 Gauzed wrapped 8 Saw cut 11 None (open hole)
 1 Continuous slot 3 Mill slot 6 Wire wrapped 9 Drilled holes
 2 Louvered shutter 4 Key punched 7 Torch cut 10 Other (specify)
 SCREEN-PERFORATED INTERVALS: From .54 ft. to .64 ft., From ... ft. to ... ft.
 GRAVEL PACK INTERVALS: From .42 ft. to .68 ft., From ... ft. to ... ft.

6 GROUT MATERIAL: 1 Neat cement 2 Cement grout Dirt 3 Bentonite 4 Other Bentonite Holeplug. & Sand
 Grout Intervals: From .5 ft. to .25 ft., From 0 ft. to .5 ft., From .25 ft. to .42 ft.
 What is the nearest source of possible contamination: FOR PILES UNIT 10 Livestock pens 14 Abandoned water well
 1 Septic tank 4 Lateral lines 7 Pit privy 11 Fuel storage 15 Oil well/Gas well
 2 Sewer lines 5 Cess pool 8 Sewage lagoon 12 Fertilizer storage 16 Other (specify below)
 3 Watertight sewer lines 6 Seepage pit 9 Feedyard 13 Insecticide storage ... None known
 Direction from well? How many feet?

FROM	TO	LITHOLOGIC LOG	FROM	TO	PLUGGING INTERVALS
0	3	Topsoil, clay			
3	48	Clay, tan			
48	54	Clay, blue			
54	56	Sand and gravel, fine			
56	63	Sand and gravel, fine, medium			
63	68	Shale, black			

7 CONTRACTOR'S OR LANDOWNER'S CERTIFICATION: This water well was (1) constructed, (2) reconstructed, or (3) plugged under my jurisdiction and was completed on (mo/day/year) 9-4-91 and this record is true to the best of my knowledge and belief. Kansas Water Well Contractor's License No. 185 This Water Well Record was completed on (mo/day/yr) 9-25-91 under the business name of Clarke Well & Equipment, Inc. by (signature)