


1 LOCATION OF WATER WELL:	Fraction	Section Number	Township Number	Range Number
County: Osborne	SW 1/4 SE 1/4 SW 1/4	13	T 7 S	R 13 E/W

Distance and direction from nearest town or city street address of well if located within city?
 Approximately 1/2 mile west of Osborne

2 WATER WELL OWNER: Osborne, City of
 RR#, St. Address, Box #: c/o City Clerk
 City, State, ZIP Code: 133 West Main, Osborne, KS 67473
 Board of Agriculture, Division of Water Resources
 Application Number: 37,012

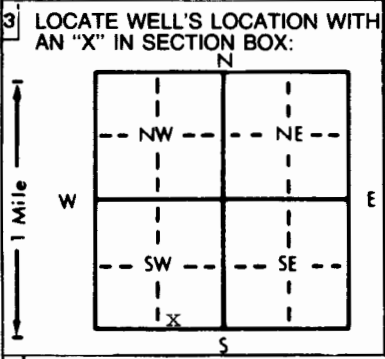

4 DEPTH OF COMPLETED WELL: 42 ft. ELEVATION: unknown

Depth(s) Groundwater Encountered: 1. ft. 2. ft. 3. ft.

WELL'S STATIC WATER LEVEL: 11 ft. below land surface measured on mo/day/yr 8-15-91

Pump test data: Well water was not ch'd. ft. after hours pumping gpm

Est. Yield unknown gpm: Well water was ft. after hours pumping gpm

Bore Hole Diameter: 18 in. to 42 ft., and in. to ft.

WELL WATER TO BE USED AS:

1 Domestic	3 Feedlot	5 Public water supply	8 Air conditioning	11 Injection well
2 Irrigation	4 Industrial	6 Oil field water supply	9 Dewatering	12 Other (Specify below)
		7 Lawn and garden only	10 Monitoring well	

Was a chemical/bacteriological sample submitted to Department? Yes.....No.....X.....; If yes, mo/day/yr sample was submitted Drilled near existing well Water Well Disinfected? Yes X No

5 TYPE OF BLANK CASING USED:

1 Steel	3 RMP (SR)	5 Wrought iron	8 Concrete tile	CASING JOINTS: Glued X Clamped
2 PVC	4 ABS	6 Asbestos-Cement	9 Other (specify below)	Welded
		7 Fiberglass		Threaded

Blank casing diameter: 8 in. to 28 ft., Dia 8 in. to 41 ft., Dia in. to ft.

Casing height above land surface: 12 in., weight 5,54 lbs./ft. Wall thickness or gauge No. 322

TYPE OF SCREEN OR PERFORATION MATERIAL:

1 Steel	3 Stainless steel	5 Fiberglass	8 RMP (SR)	10 Asbestos-cement
2 Brass	4 Galvanized steel	6 Concrete tile	9 ABS	11 Other (specify)
				12 None used (open hole)

SCREEN OR PERFORATION OPENINGS ARE:

1 Continuous slot	3 Mill slot	5 Gauzed wrapped	8 Saw cut	11 None (open hole)
2 Louvered shutter	4 Key punched	6 Wire wrapped	9 Drilled holes	
		7 Torch cut	10 Other (specify)	

SCREEN-PERFORATED INTERVALS: From 28 ft. to 37 ft., From ft. to ft., From ft. to ft.

GRAVEL PACK INTERVALS: From 25 ft. to 41 ft., From ft. to ft., From ft. to ft.

6 GROUT MATERIAL: 1 Neat cement 2 Cement grout Dirt 3 Bentonite 4 Other Bentonite Holeplug and Sand

Grout Intervals: From 4 ft. to 21 ft., From 0 ft. to 4 ft., From 21 ft. to 25 ft.

What is the nearest source of possible contamination: *FOR FILLS UNIT*

1 Septic tank	4 Lateral lines	7 Pit privy	10 Livestock pens	14 Abandoned water well
2 Sewer lines	5 Cess pool	8 Sewage lagoon	11 Fuel storage	15 Oil well/Gas well
3 Watertight sewer lines	6 Seepage pit	9 Feedyard	12 Fertilizer storage	16 Other (specify below)
			13 Insecticide storage	None known

Direction from well? How many feet?

FROM	TO	LITHOLOGIC LOG	FROM	TO	PLUGGING INTERVALS
0	7	Clay			
7	19	Sand and gravel			
19	23	Clay, black			
23	35	Sand and gravel, medium			
35	36	Sand and gravel, fine			
36	36.5	Clay streak			
36.5	37	Sand and gravel, medium			
37	42	Clay, black shale			

7 CONTRACTOR'S OR LANDOWNER'S CERTIFICATION: This water well was (1) constructed, (2) reconstructed, or (3) plugged under my jurisdiction and was completed on (mo/day/year) 8-15-91 and this record is true to the best of my knowledge and belief. Kansas Water Well Contractor's License No. 185 This Water Well Record was completed on (mo/day/yr) 9-27-91 under the business name of Clarke Well & Equipment, Inc. by (signature) *Clarke Well & Equipment*