


1 LOCATION OF WATER WELL:	Fraction	Section Number	Township Number	Range Number
County: Osborne	SW ¼ SE ¼ SW ¼	13	T 7 S	R 13 EW

Distance and direction from nearest town or city street address of well if located within city?

Approximately ½ mile west of Osborne

2 WATER WELL OWNER:	Osborne, City of c/o City Clerk 133 West Main Osborne, KS 67473	Board of Agriculture, Division of Water Resources Application Number: 37,012
---------------------	--	---

3 LOCATE WELL'S LOCATION WITH AN "X" IN SECTION BOX:

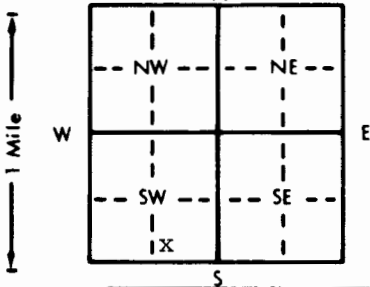

4 DEPTH OF COMPLETED WELL: 43 ft.	ELEVATION: unknown	
Depth(s) Groundwater Encountered 1. .... ft. 2. .... ft. 3. .... ft.		
WELL'S STATIC WATER LEVEL ... 10 ... ft. below land surface measured on mo/day/yr 8-15-91		
Pump test data: Well water was not ch'd. ft. after .... hours pumping .... gpm		
Est. Yield unknown gpm: Well water was .... ft. after .... hours pumping .... gpm		
Bore Hole Diameter ... 18 ... in. to ... 43 ... ft., and ... in. to ... ft.		
WELL WATER TO BE USED AS: 5 Public water supply 8 Air conditioning 11 Injection well		
1 Domestic 3 Feedlot 6 Oil field water supply 9 Dewatering 12 Other (Specify below)		
2 Irrigation 4 Industrial 7 Lawn and garden only 10 Monitoring well		
Was a chemical/bacteriological sample submitted to Department? Yes.....No.....X.....; If yes, mo/day/yr sample was submitted Drilled near existing well Water Well Disinfected? Yes X No		

5 TYPE OF CASING USED:	5 Wrought iron	8 Concrete tile	CASING JOINTS: Glued ... X ... Clamped
1 Steel	3 RMP (SR)	6 Asbestos-Cement	9 Other (specify below)
2 PVC	4 ABS	7 Fiberglass	Welded
			Threaded

Blank casing diameter ... 8 ... in. to ... 27 ... ft., Dia ... 8 ... in. to ... 42 ... ft., Dia ... in. to ... ft.  
Casing height above land surface ... 12 ... in., weight ... 5.54 ... lbs./ft. Wall thickness or gauge No. ... 322

TYPE OF SCREEN OR PERFORATION MATERIAL:	7 PVC	10 Asbestos-cement
1 Steel	3 Stainless steel	5 Fiberglass
2 Brass	4 Galvanized steel	6 Concrete tile
		8 RMP (SR)
		9 ABS
		11 Other (specify)
		12 None used (open hole)

SCREEN OR PERFORATION OPENINGS ARE:	5 Gauzed wrapped	8 Saw cut
1 Continuous slot	3 Mill slot	6 Wire wrapped
2 Louvered shutter	4 Key punched	7 Torch cut
		10 Other (specify)
		11 None (open hole)

SCREEN-PERFORATED INTERVALS:	From ... 27 ... ft. to ... 38 ... ft.,	From ... ft. to ... ft.,	From ... ft. to ... ft.
GRAVEL PACK INTERVALS:	From ... 25 ... ft. to ... 42 ... ft.,	From ... ft. to ... ft.,	From ... ft. to ... ft.

6 GROUT MATERIAL:	1 Neat cement	2 Cement grout <u>Dirt</u>	3 Bentonite	4 Other Bentonite Holeplug and Sand
Grout Intervals:	From ... 4 ... ft. to ... 21 ... ft.,	From ... 0 ... ft. to ... 4 ... ft.,	From ... 21 ... ft. to ... 25 ... ft.	
What is the nearest source of possible contamination:				
1 Septic tank	4 Lateral lines	7 Pit privy	10 Livestock pens	14 Abandoned water well
2 Sewer lines	5 Cess pool	8 Sewage lagoon	11 Fuel storage	15 Oil well/Gas well
3 Watertight sewer lines	6 Seepage pit	9 Feedyard	12 Fertilizer storage	16 Other (specify below)
			13 Insecticide storage	... None known

Direction from well? How many feet?

FROM	TO	LITHOLOGIC LOG	FROM	TO	PLUGGING INTERVALS
0	5	Clay, topsoil			
5	8	Silty clay and sand			
8	11	Clay, brown			
11	20	Sand and gravel, medium			
20	25	Sand and gravel, medium with clay streaks			
25	27	Clay			
27	33	Sand and gravel, medium			
33	36	Sand and gravel, fine			
36	38	Sand and gravel, medium			
38	43	Shale			

7 CONTRACTOR'S OR LANDOWNER'S CERTIFICATION: This water well was (1) constructed, (2) reconstructed, or (3) plugged under my jurisdiction and was completed on (mo/day/year) 8-15-91 and this record is true to the best of my knowledge and belief. Kansas Water Well Contractor's License No. 185 This Water Well Record was completed on (mo/day/yr) 9-27-91 under the business name of Clarke Well & Equipment, Inc.	by (signature) <i>Clarke Well &amp; Equipment</i>
--	---

INSTRUCTIONS: Use typewriter or ball point pen. PLEASE PRESS FIRMLY and PRINT clearly. Please fill in blanks, underline or circle the correct answers. Send top three copies to Kansas Department of Health and Environment, Bureau of Water, Topeka, Kansas 66620-0001. Telephone: 913-296-5545. Send one to WATER WELL OWNER and retain one for your records.