


1	LOCATION OF WATER WELL:	Fraction NE 40 of SE 1/4 1/4 1/4	Section Number 23	Township Number 7	Range Number 13 W
County: OSBORNE					

Distance and direction from nearest town or city street address of well if located within city?  
 FROM 1/4 MAIN OSBORNE 1 MI S 2 W, N.W. SIDE OF ROAD

2 WATER WELL OWNER: EARL EMMERSON  
 RR#, St. Address, Box #: 949 S 730TH AVE  
 Board of Agriculture, Division of Water Resources  
 Application Number:

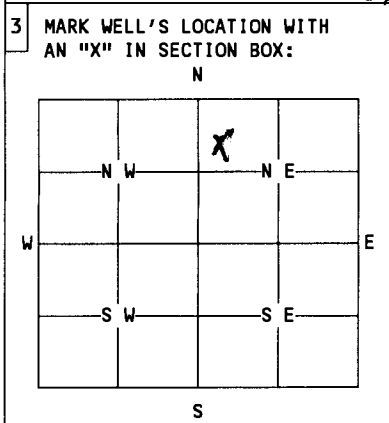

4 DEPTH OF WELL..... 42.25 .....ft.  
 WELL'S STATIC WATER LEVEL..... 70 FT WATER .....ft.  
 WELL WAS USED AS:  
 1 Domestic (circled) 5 Public Water Supply 9 Dewatering  
 2 Irrigation 6 Oil Field Water Supply 10 Monitoring Well  
 3 Feedlot 7 Lawn and Garden Only 11 Injection Well  
 4 Industrial 8 Air Conditioning 12 Other.....  
 REPLACE BY NEW WELL EAST  
 Was a chemical/bacteriological sample submitted to Department Yes X No....  
 If yes, mo/day/yr sample was submitted... 1... 9... NEW WELL  
 Water Well Disinfected: Yes X No..... OLD & NEW

5 TYPE OF BLANK CASING USED:

1 Steel	3 RMP (SR)	5 Wrought	7 Fiberglass	9 Other (specify below)
2 PVC	4 ABS	6 Asbestos-Cement	8 Concrete Tile (circled)	

Blank casing diameter... 4 .....in. Was casing pulled? Yes X No..... If yes, how much, BELOW LAND SURFACE  
 Casing height above or below land surface... below pit floor in 4 in. LAND SURFACE

6 GROUT PLUG MATERIAL: 1 Neat cement 2 Cement grout 3 Bentonite 4 Other.....  
 Grout Plug Intervals: SAND From.....ft. to 27.15 FT CONCRETE GROUT TO SURFACE  
 What is the nearest source of possible contamination:  
 1 Septic tank (circled) 6 Seepage pit 11 Fuel storage 16 Other (specify below)  
 2 Sewer lines 7 Pit privy 12 Fertilizer storage  
 3 Watertight sewer lines 8 Sewage lagoon 13 Insecticide storage  
 4 Lateral lines 9 Feedyard 14 Abandoned water well  
 5 Cess Pool 10 Livestock pens 15 Oil well/Gas well  
 Direction from well? S.W. How many feet? 62

FROM	TO	PLUGGING MATERIALS

NO LEAKAGE AT TANK  
 SEWER LINE DISCHARGE  
 MORE THAN 100 FT  
 WEST.

7 CONTRACTOR'S OR LANDOWNER'S CERTIFICATION: This water well was plugged under my jurisdiction and was completed on (mo/day/year) 4/1/91 and this record is true to the best of my knowledge and belief. Kansas Water Well Contractor's License No. 3717-91 This Water Well Record was completed on (mo/day/year) 3-11-91 under the business name of Earl Emmerson, Landowner by (signature) Earl Emmerson, Landowner

INSTRUCTIONS: Use typewriter or ball point pen. Please press firmly and print clearly. Please fill in blanks, underline or circle the correct answers. Send top three copies to Kansas Department of Health and Environment, Bureau of Water, Topeka, Kansas 66620-0001. Telephone: 913/296-3565. Send one to Water Well Owner and retain one for your records.