


1 LOCATION OF WATER WELL: County: Rooks	Fraction NW 1/4 NW 1/4 NW 1/4	Section Number 7	Township Number T 7 S	Range Number R 16 E
---	---	----------------------------	---------------------------------	-------------------------------

Distance and direction from nearest town or city street address of well if located within city?
3 west 1 north of Woodston, KS

2 WATER WELL OWNER: **Frank Dix**
 RR#, St. Address, Box # : **2730 J RD**
 City, State, ZIP Code : **Woodston, KS 67675**
 Board of Agriculture, Division of Water Resources
 Application Number:

3 LOCATE WELL'S LOCATION WITH AN "X" IN SECTION BOX:

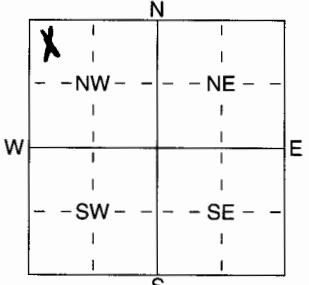

4 DEPTH OF COMPLETED WELL **45** ft. ELEVATION:

Depth(s) Groundwater Encountered **1** ft. 2 ft. 3 ft.
 WELL'S STATIC WATER LEVEL **27** ft. below land surface measured on mo/day/yr **8/25/05**
 Pump test data: Well water was **27** ft. after **2** hours pumping **20** gpm
 Est. Yield **20** gpm: Well water was ft. after hours pumping gpm
 WELL WATER TO BE USED AS: **1** 5 Public water supply 8 Air conditioning 11 Injection well
 1 Domestic 3 Feedlot 6 Oil field water supply 9 Dewatering 12 Other (Specify below)
 2 Irrigation 4 Industrial 7 Domestic (lawn & garden) 10 Monitoring well

Was a chemical/bacteriological sample submitted to Department? Yes No **X**; If yes, mo/day/yr sample was submitted
 Water Well Disinfected? **Yes** No

5 TYPE OF BLANK CASING USED: **2**

1 Steel	3 RMP (SR)	5 Wrought iron	8 Concrete tile	CASING JOINTS: Glued X Clamped
2 PVC	4 ABS	6 Asbestos-Cement	9 Other (specify below)	Welded
	5 5"	7 Fiberglass		Threaded

Blank casing diameter **16** in. to **25** ft., Dia in. to ft., Dia in. to ft.
 Casing height above land surface in., weight **2.91** lbs./ft. Wall thickness or gauge No. **.21**

TYPE OF SCREEN OR PERFORATION MATERIAL: **7**

1 Steel	3 Stainless Steel	5 Fiberglass	7 PVC	10 Asbestos-Cement
2 Brass	4 Galvanized Steel	6 Concrete tile	8 RMP (SR)	11 Other (Specify)
			9 ABS	12 None used (open hole)

SCREEN OR PERFORATION OPENINGS ARE: **8**

1 Continuous slot	3 Mill slot	5 Gauzed wrapped	8 Saw cut	11 None (open hole)
2 Louvered shutter	4 Key punched	6 Wire wrapped	9 Drilled holes	
		7 Torch cut	10 Other (specify)	

SCREEN-PERFORATED INTERVALS: From **25** ft. to **45** ft., From ft. to ft.
 GRAVEL PACK INTERVALS: From **20** ft. to **45** ft., From ft. to ft.
 From ft. to ft., From ft. to ft.

6 GROUT MATERIAL: **3**

1 Neat cement	2 Cement grout	3 Bentonite	4 Other
---------------	----------------	--------------------	---------------

Grout intervals: From **0** ft. to **20** ft., From ft. to ft., From ft. to ft.

What is the nearest source of possible contamination:

1 Septic tank	4 Lateral lines	7 Pit privy	10 Livestock pens	14 Abandoned water well
2 Sewer lines	5 Cess pool	8 Sewage lagoon	11 Fuel storage	15 Oil well/Gas well
3 Watertight sewer lines	6 Seepage pit	9 Feedyard	12 Fertilizer storage	16 Other (specify below)
			13 Insecticide storage	

Direction from well? How many feet?

FROM	TO	LITHOLOGIC LOG	FROM	TO	PLUGGING INTERVALS
0	15	Top Soil And Clays			
15	29	Loose rock and sand			
29	45	Shale			

7 CONTRACTOR'S OR LANDOWNER'S CERTIFICATION: This water well was (1) constructed, (2) reconstructed, or (3) plugged under my jurisdiction and was completed on (mo/day/year) **8-25-05** and this record is true to the best of my knowledge and belief. Kansas Water Well Contractor's Licence No **#199** This Water Well Record was completed on (mo/day/yr) **9/8/05** under the business name of **Karst Water Well Drilling & Service, INC** by (signature) *[Signature]*