


1 LOCATION OF WATER WELL: County: **Rooks** Fraction: **SW 1/4 NW 1/4 SW 1/4** Section Number: **10** Township Number: **T 7 S** Range Number: **R 16 E/W**

Distance and direction from nearest town or city street address of well if located within city?  
**Hwy 24 & Pine Street, Woodston**

2 WATER WELL OWNER: **Patrick Lingg**  
 RR#, St. Address, Box #: **PO Box 542** Board of Agriculture, Division of Water Resources  
 City, State, ZIP Code: **Stockton, Rooks Kansas** Application Number:

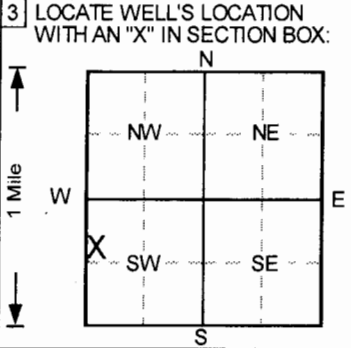

4 DEPTH OF COMPLETED WELL: **56** ft ELEVATION: .....  
 Depth(s) Groundwater Encountered 1. .... ft 2. .... ft 3. .... ft  
 WELL'S STATIC WATER LEVEL ..... ft below land surface measured on mo/day/yr  
 Pump test data: Well water was **NA** ft after ..... hours pumping ..... gpm  
 Est. Yield **NA** gpm: Well water was ..... ft after ..... hours pumping ..... gpm  
 Bore Hole Diameter **8** in. to **56** ft, and ..... in. to ..... ft.  
 WELL WATER TO BE USED AS: 5 Public water supply 8 Air conditioning 11 Injection well  
 1 Domestic 3 Feedlot 6 Oil field water supply 9 Dewatering **12 Other (Specify below)**  
 2 Irrigation 4 Industrial 7 Lawn and garden only 10 Monitoring well **Air sparge**  
 Was a chemical/bacteriological sample submitted to Department? Yes.....No ; If yes, mo/day/yr sample was submitted  
 Water Well Disinfected? Yes No

5 TYPE OF BLANK CASING USED: 5 Wrought iron 8 Concrete tile CASING JOINTS: Glued ..... Clamped .....  
 1 Steel 3 RMP (SR) 6 Asbestos-Cement 9 Other (specify below) Welded .....  
**2 PVC** 4 ABS 7 Fiberglass Threaded.   
 Blank casing diameter **2** in. to **52** ft, Dia **2** in. to **56** ft, Dia ..... in. to ..... ft  
 Casing height above land surface ..... in., weight ..... lbs./ft. Wall thickness or gauge No. **Sch. 40**  
 TYPE OF SCREEN OR PERFORATION MATERIAL **7 PVC** 10 Asbestos-cement  
 1 Steel 3 Stainless steel 5 Fiberglass **8 RMP (SR)** 11 Other (specify) .....  
 2 Brass 4 Galvanized steel 6 Concrete tile 9 ABS 12 None used (open hole)  
 SCREEN OR PERFORATION OPENINGS ARE: 5 Gauzed wrapped 8 Saw cut 11 None (open hole)  
 1 Continuous slot **3 Mill slot** 6 Wire wrapped 9 Drilled holes  
 2 Louvered shutter 4 Key punched 7 Torch cut 10 Other (specify) .....  
 SCREEN-PERFORATED INTERVALS: From **52** ft to **54** ft, From ..... ft to ..... ft  
 From ..... ft to ..... ft, From ..... ft to ..... ft  
 GRAVEL PACK INTERVALS: From **50** ft to **56** ft, From ..... ft to ..... ft  
 From ..... ft to ..... ft, From ..... ft to ..... ft

6 GROUT MATERIAL: 1 Neat cement 2 Cement grout **3 Bentonite** 4 Other .....  
 Grout Intervals: From **3** ft to **50** ft, From ..... ft to ..... ft, From ..... ft to ..... ft  
 What is the nearest source of possible contamination:  
 1 Septic tank 4 Lateral lines 7 Pit privy 10 Livestock pens 14 Abandoned water well  
 2 Sewer lines 5 Cess pool 8 Sewage lagoon 11 Fuel storage 15 Oil well/Gas well  
 3 Watertight sewer lines 6 Seepage pit 9 Feedyard 12 Fertilizer storage 16 Other (specify below)  
 13 Insecticide storage  
 Direction from well? How many feet?

FROM	TO	LITHOLOGIC LOG	FROM	TO	PLUGGING INTERVALS
0	0.5	Concrete,			
0.5	6	Clay, silty, LS clasts, Dark Brown to Brown			
6	17	Clay, v. silty, Yellow Brown			
17	24	Silt, clayey w/clay stringers, Yellow Brown			
24	30	Clay, silty, Brown to Yellow Brown			
30	35	Sand, vf-f, silty, Gray			
35	47	Sand, vfc w/f gravel, Gray to Dark Gray			
47	56	Sand, f-c w/f gravel, Brown			
					AS10, Flushmount

7 CONTRACTOR'S OR LANDOWNER'S CERTIFICATION: This water well was **1** constructed, (2) reconstructed, or (3) plugged under my jurisdiction and was completed on (mo/day/year) **10/6/2010** and this record is true to the best of my knowledge and belief.  
 Kansas Water Well Contractor's License No. **527**. This Water Well Record was completed on (mo/day/yr) **10/22/2016**  
 under the business name of **GeoCore, Inc.** by (signature) *Dave Akal*