

WATER WELL RECORD

Form WWC-5


Division of Water Resources App. No.

8063

1 LOCATION OF WATER WELL: County: Rooks Fraction: 1/4 NW 1/4 SE 1/4 SE 1/4 Section Number: 9 Township No. T 7 S Range Number R 16 E W

Street/Rural Address of Well Location; if unknown, distance & direction from nearest town or intersection: If at owner's address, check here [ ] Approximately 500 feet south and 1000 feet west of woodston. Global Positioning System (GPS) information: Latitude: 39.454067 Longitude: -99.104613 Elevation: unknown

2 WATER WELL OWNER: City of Woodston RR#, Street Address, Box #: 512 Main St. City, State, ZIP Code : Woodston, KS 67675 Datum: [ ] WGS 84, [X] NAD 83, [ ] NAD 27 Collection Method: [X] GPS unit (Make/Model: WAAS) [ ] Digital Map/Photo, [ ] Topographic Map, [ ] Land Survey Est. Accuracy: [ ] <3 m, [X] 3-5 m, [ ] 5-15 m, [ ] >15 m

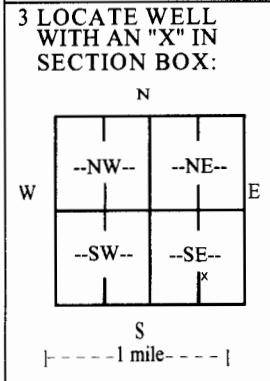

3 LOCATE WELL WITH AN "X" IN SECTION BOX: 4 DEPTH OF COMPLETED WELL 60 ft. Depth(s) Groundwater Encountered (1) 37.40 ft. (2) ft. (3) ft. WELL'S STATIC WATER LEVEL 37.40 ft. below land surface measured on mo/day/yr 10/5/11 Pump test data: Well water was Not checked ft. after hours pumping gpm EST. YIELD gpm. Well water was ft. after hours pumping gpm Bore Hole Diameter 26 in. to 60 ft., and in. to ft. WELL WATER TO BE USED AS: [X] Public water supply [ ] Geothermal [ ] Injection well [ ] Domestic [ ] Feedlot [ ] Oil field water supply [ ] Dewatering [ ] Other (Specify below) [ ] Irrigation [ ] Industrial [ ] Domestic-lawn & garden [ ] Monitoring well Was a chemical/bacteriological sample submitted to Department? [ ] Yes [X] No If yes, mo/day/yr sample was submitted Water well disinfected? [X] Yes [ ] No

5 TYPE OF CASING USED: [X] Steel [ ] PVC [ ] Other CASING JOINTS: [ ] Glued [ ] Clamped [X] Welded [ ] Threaded Casing diameter in. to ft., Diameter 12 in. to 47 ft., Diameter in. to ft. Casing height above land surface 36 in., Weight 49.61 lbs./ft., Wall thickness or gauge No. 375 TYPE OF SCREEN OR PERFORATION MATERIAL: [ ] Steel [X] Stainless Steel [ ] PVC [ ] Brass [ ] Galvanized Steel [ ] None used (open hole) [ ] Other (Specify) SCREEN OR PERFORATION OPENINGS ARE: [ ] Continuous slot [ ] Mill slot [ ] Gauze wrapped [ ] Torch cut [ ] Drilled holes [ ] None (open hole) [ ] Louvered shutter [ ] Key punched [X] Wire wrapped [ ] Saw cut [ ] Other (specify) SCREEN-PERFORATED INTERVALS: From 47 ft. to 57 ft., From ft. to ft. From ft. to ft., From ft. to ft. GRAVEL PACK INTERVALS: From 37 ft. to 60 ft., From ft. to ft. From ft. to ft., From ft. to ft.

6 GROUT MATERIAL: [ ] Neat cement [X] Cement grout [X] Bentonite [X] Other Bentonite/Sand Mix Grout Intervals: From 4 ft. to 24 ft., From 24 ft. to 32 ft., From 32 ft. to 37 ft. What is the nearest source of possible contamination: [ ] Septic tank [ ] Lateral lines [ ] Pit privy [ ] Livestock pens [ ] Insecticide storage [X] Other (specify below) [ ] Sewer lines [ ] Cesspool [ ] Sewage lagoon [ ] Fuel storage [ ] Abandoned water well [ ] Watertight sewer lines [ ] Seepage pit [ ] Feedyard [ ] Fertilizer storage [ ] Oil well/gas well None Known Direction from well Distance from well

Table with columns: FROM, TO, LITHOLOGIC LOG, FROM, TO, LITHO. LOG (cont.) or PLUGGING INTERVALS. Rows describe soil layers from 0 to 60 feet depth.

7 CONTRACTOR'S OR LANDOWNER'S CERTIFICATION: This water well was [X] constructed, [ ] reconstructed, or [ ] plugged under my jurisdiction and was completed on (mo/day/year) 10/5/11 and this record is true to the best of my knowledge and belief. Kansas Water Well Contractor's License No. 185 This Water Well Record was completed on (mo/day/year) 10/11/11 under the business name of Clarke Well & Equipment, Inc. by (signature)

INSTRUCTIONS: Use typewriter or ball point pen. PLEASE PRESS FIRMLY and PRINT clearly. Please fill in blanks and check the correct answers. Send three copies (white, blue, pink) to Kansas Department of Health and Environment, Bureau of Water, Geology Section, 1000 SW Jackson St., Suite 420, Topeka, Kansas 66612-1367. Telephone 785-296-5522. Send one copy to WATER WELL OWNER and retain one for your records. Include fee of \$5.00 for each constructed well. Visit us at http://www.kdheks.gov/waterwell/index.html.