

CORRECTION(S) TO WATER WELL RECORD (WWC-5)
(to rectify lacking or incorrect information)

County: Rooks

Location listed as:

Section-Township-Range: 23 - 57 - W18

Fraction (1/4 1/4 1/4): None Given

Location changed to:

23 - 75 - 18W

SE NW SW

Other changes: Initial statements: _____

Changed to: _____

Comments: _____

verification method: Legal description, position on plat map,
other City of Stockton wells in this section.


initials: DRJ date: 8/29/2005

submitted by: Kansas Geological Survey, Data Resources Library, 1930 Constant Ave., Lawrence, KS 66047-3726
to: Kansas Dept of Health & Environment, Bureau of Water, 1000 SW Jackson, Suite 420, Topeka, KS 66612-1367.

1 LOCATION OF WATER WELL:	Fraction	Section	Number	Township	Number	Range	Number
County: <u>Rooks</u>	$\frac{1}{4}$ $\frac{1}{4}$ $\frac{1}{4}$	<u>23</u>		<u>S</u>	<u>7</u>	<u>W</u>	<u>18</u> E/W

Distance and direction from nearest town or city street address of well if located within city?

2 WATER WELL OWNER: City of Stockton well 12
 RR #, St. Address, Box #: 115 S. Walnut
 City, State, ZIP Code: Stockton Kansas 67669
 Board of Agriculture, Division of Water Resources
 Application Number: _____

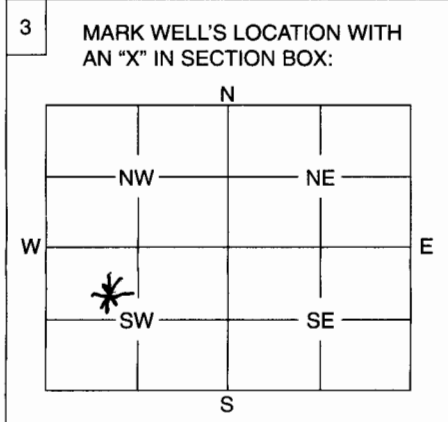

4 DEPTH OF WELL 44' ft.
 WELL'S STATIC WATER LEVEL 29 ft.
 WELL WAS USED AS:
 1 Domestic 5 Public Water Supply 9 Dewatering
 2 Irrigation 6 Oil Field Water Supply 10 Monitoring Well
 3 Feedlot 7 Domestic (Lawn & Garden) 11 Injection Well
 4 Industrial 8 Air Conditioning 12 Other

Was a chemical / bacteriological sample submitted to Department? Yes No
 If yes, mo/day/yr sample was submitted

Water Well Disinfected: Yes No

5 TYPE OF BLANK CASING USED:
 1 Steel 3 RMP (SR) 5 Wrought 7 Fiberglass 9 Other (Specify below)
 2 PVC 4 ABS 6 Asbestos-Cement 8 Concrete Tile

Blank casing diameter 12 in. Was casing pulled? Yes No
 Casing height above or below land surface in. If yes, how much

6 GROUT PLUG MATERIAL: 1 Neat cement 2 Cement grout 3 Bentonite 4 Other

Grout Plug Intervals: From 44 ft. to 3 ft., From ft. to ft., From to ft.

What is the nearest source of possible contamination:
 1 Septic tank 6 Seepage pit 11 Fuel storage 16 Other (specify below)
 2 Sewer lines 7 Pit privy 12 Fertilizer storage

Direction from well? NW How many feet? 500

FROM	TO	PLUGGING MATERIALS
<u>44'</u>	<u>4'</u>	<u>Concrete all way to 3'</u>
<u>Bottom</u>	<u>Top</u>	<u>Below ground level</u>

7 CONTRACTOR'S OF LANDOWNER'S CERTIFICATION: This water well was plugged under my jurisdiction and was completed on (mo/day/year) July 20 2005 and this record is true to the best of my knowledge and belief. Kansas Water Well Contractor's License No. _____ This Water Well Record was completed on (mo/day/year) Aug 3 2005 under the business name of City of Stockton by (signature) Alec P. Hake water Superintendent

INSTRUCTIONS: Use typewriter or ball point pen. Please press firmly and print clearly. Please fill in blanks, underline or circle the correct answers. Send top three copies to Kansas Department of Health and Environment, Bureau of Water, Geology Section, 1000 SW Jackson St., Ste. 420, Topeka, Kansas 66612-1367. Telephone: 785/296-5522. Send one to Water Well Owner and retain one for your records.