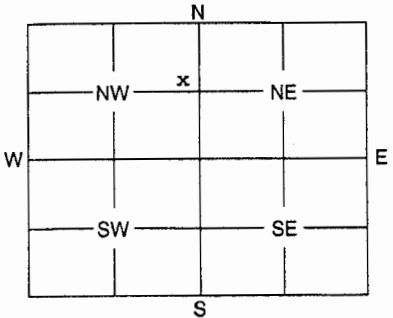


1	LOCATION OF WATER WELL:	Fraction	Section Number	Township Number	Range Number
County:	Rooks	SE ¼ NE ¼ NW ¼	24	7	18

Distance and direction from nearest town or city street address of well if located within city?
321 S. Cypress Street - Stockton, KS

2	WATER WELL OWNER:	Kansas Department of Trans.	
	RR #, St. Address, Box #:	Box 268	.Board of Agriculture, Division of Water Resources
	City, State, ZIP Code :	Phillipsburg, KS 67661	Application Number:

3	MARK WELL'S LOCATION WITH AN "X" IN SECTION BOX:	4	DEPTH OF WELL 30 ft.
			WELL'S STATIC WATER LEVEL 24.5 ft.
			WELL WAS USED AS:
		1 Domestic	5 Public Water Supply
		2 Irrigation	6 Oil Field Water Supply
		3 Feedlot	7 Domestic (Lawn & Garden)
		4 Industrial	8 Air Conditioning
			9 Dewatering
			10 Monitoring Well MW-6A
			11 Injection Well
			12 Other

Was a chemical / bacteriological sample submitted to Department? Yes No
 If yes, mo/day/yr sample was submitted

Water Well Disinfected: Yes No

5	TYPE OF BLANK CASING USED:
	1 Steel 3 RMP (SR) 5 Wrought 7 Fiberglass 9 Other (Specify below) <input checked="" type="checkbox"/> 2 PVC 4 ABS 6 Asbestos-Cement 8 Concrete Tile
	Blank casing diameter 2 in. Was casing pulled? Yes <input checked="" type="checkbox"/> No If yes, how much 3'
	Casing height above or <u>below</u> land surface in.

6	GROUT PLUG MATERIAL:	1 Neat cement	2 Cement grout	<input checked="" type="checkbox"/> 3 Bentonite	4 Other
	Grout Plug Intervals:	From 0.5 ft. to 30 ft.,	From ft. to ft.,	From ft. to ft.,	From to ft.
	What is the nearest source of possible contamination:				
	1 Septic tank	6 Seepage pit	<input checked="" type="checkbox"/> 11 Fuel storage	16 Other (specify below)	
	2 Sewer lines	7 Pit privy	12 Fertilizer storage	
	3 Watertight sewer lines	8 Sewage lagoon	13 Insecticide storage	
	4 Lateral lines	9 Feedyard	14 Abandoned water well	
	5 Cess pool	10 Livestock pens	15 Oil well/Gas well	
	Direction from well? west	How many feet? 150		

FROM	TO	PLUGGING MATERIALS
0	0.5	Asphalt
0.5	30	Bentonite slurry

7	CONTRACTOR'S OR LANDOWNER'S CERTIFICATION: This water well was plugged under my jurisdiction and was completed on (mo/day/year) 9-24-07 and this record is true to the best of my knowledge and belief. Kansas Water Well Contractor's License No. 735 This Water Well Record was completed on (mo/day/year) 9-28-07 under the business name of MILCO Environmental Services, Inc. by (signature)
---	---

INSTRUCTIONS: Use typewriter or ball point pen. Please press firmly and print clearly. Please fill in blanks, underline or circle the correct answers. Send top three copies to Kansas Department of Health and Environment, Bureau of Water, Geology Section, 1000 SW Jackson St., Ste. 420, Topeka, Kansas 66612-1367. Telephone: 785/296-5522. Send one to Water Well Owner and retain one for your records.