


1 LOCATION OF WATER WELL: County: Cloud Fraction: SW 1/4 SW 1/4 SW 1/4 Section Number: 23 Township Number: T-7 S Range Number: R-2 E/W

Distance and direction from nearest town or city street address of well if located within city?

2 WATER WELL OWNER: BETH BLACKWELL
 RR#, St. Address, Box #: 100 Kansas
 City, State, ZIP Code: AURORA, NE 67417
 Board of Agriculture, Division of Water Resources
 Application Number:

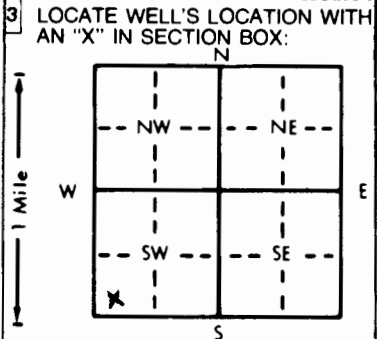

4 DEPTH OF COMPLETED WELL: 215 ft. ELEVATION: _____ ft.
 Depth(s) Groundwater Encountered: 1. 83' ft. 2. _____ ft. 3. _____ ft.
 WELL'S STATIC WATER LEVEL: 83' ft. below land surface measured on mo/day/yr
 Pump test data: Well water was 200 ft. after 8 hours pumping 2 gpm
 Est. Yield: 2 gpm; Well water was _____ ft. after _____ hours pumping _____ gpm
 Bore Hole Diameter: 10 in. to _____ ft. and _____ in. to _____ ft.
 WELL WATER TO BE USED AS:
 1 Domestic 3 Feedlot 6 Oil field water supply 9 Dewatering 12 Other (Specify below)
 2 Irrigation 4 Industrial 7 Lawn and garden only 10 Monitoring well
 Was a chemical/bacteriological sample submitted to Department? Yes _____ No X; If yes, mo/day/yr sample was submitted _____
 Water Well Disinfected? Yes X No _____

5 TYPE OF BLANK CASING USED:
 1 Steel 3 RMP (SR) 5 Wrought iron 8 Concrete tile CASING JOINTS: Glued X Clamped _____
 2 PVC 4 ABS 7 Fiberglass _____ Threaded _____
 Blank casing diameter: 4.5 in. to 17.5 ft. Dia. _____ in. to _____ ft. Dia. _____ in. to _____ ft.
 Casing height above land surface: 24 in. weight: plus 200 lbs./ft. Wall thickness or gauge No. _____
 TYPE OF SCREEN OR PERFORATION MATERIAL:
 1 Steel 3 Stainless steel 5 Fiberglass 8 RMP (SR) 11 Other (specify) _____
 2 Brass 4 Galvanized steel 6 Concrete tile 9 ABS 12 None used (open hole) _____
 SCREEN OR PERFORATION OPENINGS ARE:
 1 Continuous slot 3 Mill slot 5 Gauzed wrapped 8 Saw cut 11 None (open hole)
 2 Louvered shutter 4 Key punched 7 Torch cut 9 Drilled holes _____
 SCREEN-PERFORATED INTERVALS: From 195 ft. to 215 ft. From _____ ft. to _____ ft.
 GRAVEL PACK INTERVALS: From 2.15 ft. to 10 ft. From _____ ft. to _____ ft.

6 GROUT MATERIAL: 1 Neat cement 2 Cement grout 3 Bentonite 4 Other _____
 Grout Intervals: From 0 ft. to 20 ft. From _____ ft. to _____ ft. From _____ ft. to _____ ft.
 What is the nearest source of possible contamination:
 1 Septic tank 4 Lateral lines 7 Pit privy 10 Livestock pens 14 Abandoned water well
 2 Sewer lines 5 Cess pool 8 Sewage lagoon 11 Fuel storage 15 Oil well/Gas well
 3 Watertight sewer lines 6 Seepage pit 9 Feedyard 12 Fertilizer storage 16 Other (specify below) _____
 Direction from well? How many feet? 50'-14 150-1

FROM	TO	LITHOLOGIC LOG	FROM	TO	PLUGGING INTERVALS
0	10	Top soil & clay			
10	30	Brown & Gray clay			
30	50	Sandy clay			
50	70	Clay & sandy clay			
70	100	Fine sand & clay			
100	120	Gray clay & sandy clay			
120	150	Sandy clay & some Gravel			
150	180	Sand & Some Gravel			
180	200	Sandstone			
200	215	Blue clay			

7 CONTRACTOR'S OR LANDOWNER'S CERTIFICATION: This water well was (1) constructed, (2) reconstructed, or (3) plugged under my jurisdiction and was completed on (mo/day/year) 4/14/97 and this record is true to the best of my knowledge and belief. Kansas Water Well Contractor's License No. 480 This Water Well Record was completed on (mo/day/yr) 4/21/97 under the business name of WILLIAMS DRILLING CO. INC. by (signature) [Signature]