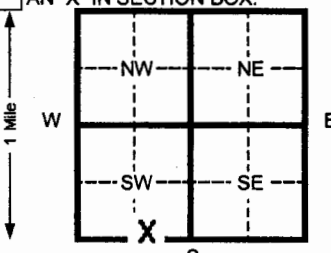


WATER WELL RECORD Form WWC-5 KSA 82a-1212 ID No. 00363688

1 LOCATION OF WATER WELL:		Fraction		Section Number		Township Number		Range Number	
County: Cloud		SW ¼ SE ¼ SW ¼		10		T 07 S		R 02 W	
Distance and direction from nearest town or city street address of well if located within city? 291 E. Main Street, Aurora									
2 WATER WELL OWNER:		KDHE							
RR#, St. Address, Box #		1000 SW Jackson Suite 410				Board of Agriculture, Division of Water Resources			
City, State, ZIP Code		Topeka, KS 66612				Application Number:			
3 LOCATE WELL'S LOCATION WITH AN "X" IN SECTION BOX:		4 DEPTH OF COMPLETED WELL 25 ft. ELEVATION: 95.89 TOC							
		Depth(s) Groundwater Encountered 1 dry ft. 2 ft. 3 ft. WELL'S STATIC WATER LEVEL 22.1 ft. below land surface measured on mo/day/yr 6-16-05 Pump test data: Well water was ft. after hours pumping gpm Est. Yield gpm: Well water was ft. after hours pumping gpm Bore Hole Diameter 8.5 in. to 25 ft. and in. to ft. WELL WATER TO BE USED AS: 5 Public water supply 8 Air conditioning 11 Injection well 1 Domestic 3 Feed lot 6 Oil field water supply 9 Dewatering 12 Other (Specify below) 2 Irrigation 4 Industrial 7 Lawn and garden (domestic) 10 Monitoring well Was a chemical/bacteriological sample submitted to Department? Yes No X If yes, mo/day/yr sample was submitted Water Well Disinfected? Yes No X							
5 TYPE OF BLANK CASING USED:		5 Wrought Iron 8 Concrete tile CASING JOINTS: Glued Clamped 1 Steel 3 RMP (SR) Welded 2 PVC 4 ABS 7 Fiberglass Threaded Flush Blank casing diameter 2 in. to 10 ft., Dia in. to ft., Dia in. to ft. Casing height above land surface Flushmount in., weight 0.703 lbs./ft. Wall thickness or gauge No. Sch. 40							
TYPE OF SCREEN OR PERFORATION MATERIAL:		7 PVC 10 Asbestos-cement 1 Steel 3 Stainless steel 5 Fiberglass 8 RMP (SR) 11 Other (specify) 2 Brass 4 Galvanized steel 6 Concrete tile 9 ABS 12 None used (open hole) SCREEN OR PERFORATION OPENINGS ARE: 5 Gauzed wrapped 8 Saw cut 11 None (open hole) 1 Continuous slot 3 Mill slot 6 Wire wrapped 9 Drilled holes 2 Louvered shutter 4 Key punched 7 Torch cut 10 Other (specify)							
SCREEN-PERFORATED INTERVALS:		From 10 ft. to 25 ft. From ft. to ft. From ft. to ft. From ft. to ft. GRAVEL PACK INTERVALS: From 8 ft. to 25 ft. From ft. to ft. From ft. to ft. From ft. to ft.							
6 GROUT MATERIAL:		1 Neat cement 2 Cement grout 3 Bentonite 4 Other Grout Intervals From 0.5 ft. to 8 ft. From ft. to ft. From ft. to ft. What is the nearest source of possible contamination: 1 Septic tank 4 Lateral lines 7 Pit privy 10 Livestock pens 14 Abandoned water well 2 Sewer lines 5 Cess pool 8 Sewage lagoon 11 Fuel storage 15 Oil well/ Gas well 3 Watertight sewer lines 6 Seepage pit 9 Feedyard 12 Fertilizer storage 16 Other (specify below) 13 Insecticide storage Direction from well? How many feet?							
FROM TO CODE LITHOLOGIC LOG FROM TO PLUGGING INTERVALS									
0 4		Fill, clay and brick							
4 14		Weathered Claystone - Silty clay							
14 18		CL-ML Silty sandy clay							
18 22		CL-ML Sandstone							
22 25		CL-ML Claystone - Silty clay							
7 CONTRACTOR'S OR LANDOWNER'S CERTIFICATION:		This water well was (1) constructed, (2) reconstructed, or (3) plugged under my jurisdiction and was completed on (mo/day/yr) 7-18-05 and this record is true to the best of my knowledge and belief. Kansas Water Well Contractor's License No. 531 This Water Well Record was completed on (mo/day/yr) 8-19-05 under the business name of Geotechnical Services, Inc. by (signature) [Signature]							
INSTRUCTIONS: Please fill in blanks and circle the correct answers. Send three copies to Kansas Department of Health and Environment, Bureau of Water, 1000 S W Jackson St., Ste. 420, Topeka, Kansas 66612-1367. Telephone: 913-296-5545. Send one to WATER WELL OWNER and retain one for your records.									