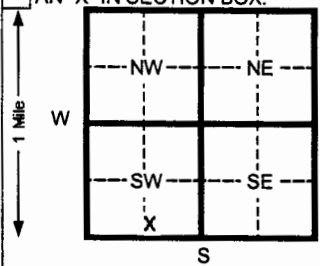


1 LOCATION OF WATER WELL:	Fraction	Section Number	Township Number	Range Number
County: <b>Cloud</b>	<b>SW</b> $\frac{1}{4}$ <b>SE</b> $\frac{1}{4}$ <b>SW</b> $\frac{1}{4}$	<b>10</b>	T <b>07</b> S	R <b>02</b> W

Distance and direction from nearest town or city street address of well if located within city?

**West of intersection Main St. and Second St., Aurora**


2 WATER WELL OWNER:	<b>KDHE</b>	Board of Agriculture, Division of Water Resources
RR#, St. Address, Box # :	<b>1000 SW Jackson Suite 410</b>	Application Number:
City, State, ZIP Code :	<b>Topeka, KS 66612</b>	

3 LOCATE WELL'S LOCATION WITH AN "X" IN SECTION BOX:	4 DEPTH OF COMPLETED WELL	ELEVATION:
	<b>25</b> ft.	<b>89.05 (TOC)</b>
	Depth(s) Groundwater Encountered 1 <b>18</b> ft. 2 _____ ft. 3 _____ ft.	
	WELL'S STATIC WATER LEVEL <b>14.16</b> ft. below land surface measured on mo/day/yr <b>05/16/07</b>	
	Pump test data: Well water was _____ ft. after _____ hours pumping _____ gpm	
	Est. Yield _____ gpm: Well water was _____ ft. after _____ hours pumping _____ gpm	
	Bore Hole Diameter <b>8.5</b> in. to <b>25</b> ft. and _____ in. to _____ ft.	
	WELL WATER TO BE USED AS: 5 Public water supply 8 Air conditioning 11 Injection well	
	1 Domestic 3 Feed lot 6 Oil field water supply 9 Dewatering 12 Other (Specify below)	
	2 Irrigation 4 Industrial 7 Lawn and garden (domestic) <b>10 Monitoring well</b>	
	Was a chemical/bacteriological sample submitted to Department? Yes _____ No <b>X</b> If yes, mo/day/yr sample was submitted	
	Water Well Disinfected? Yes _____ No <b>X</b>	

5 TYPE OF BLANK CASING USED:	5 Wrought iron	8 Concrete tile	CASING JOINTS: Glued _____ Clamped _____
1 Steel	3 RMP (SR)	6 Asbestos-Cement	9 Other (specify below) _____
<b>2 PVC</b>	4 ABS	7 Fiberglass	Welded _____
Blank casing diameter <b>2</b> in. to <b>10</b> ft., Dia			Threaded <b>Flush</b>
Casing height above land surface <b>Flushmount</b> in., weight <b>0.703</b> lbs./ft. Wall thickness or gauge No. <b>Sch. 40</b>			
TYPE OF SCREEN OR PERFORATION MATERIAL:	<b>7 PVC</b>	10 Asbestos-cement	
1 Steel	3 Stainless steel	5 Fiberglass	8 RMP (SR)
2 Brass	4 Galvanized steel	6 Concrete tile	9 ABS
SCREEN OR PERFORATION OPENINGS ARE:	5 Gauzed wrapped	8 Saw cut	11 None (open hole)
1 Continuous slot	<b>3 Mill slot</b>	6 Wire wrapped	9 Drilled holes
2 Louvered shutter	4 Key punched	7 Torch cut	10 Other (specify) _____
SCREEN-PERFORATED INTERVALS:	From <b>10</b> ft. to <b>25</b> ft.	From _____ ft. to _____ ft.	
GRAVEL PACK INTERVALS:	From <b>8</b> ft. to <b>25</b> ft.	From _____ ft. to _____ ft.	

6 GROUT MATERIAL:	1 Neat cement	2 Cement grout	<b>3 Bentonite</b>	4 Other _____
Grout Intervals From <b>1.5</b> ft. to <b>8</b> ft. From _____ ft. to _____ ft.				
What is the nearest source of possible contamination:	10 Livestock pens	14 Abandoned water well		
1 Septic tank	4 Lateral lines	7 Pit privy	11 Fuel storage	15 Oil well/ Gas well
2 Sewer lines	5 Cess pool	8 Sewage lagoon	12 Fertilizer storage	16 Other (specify below)
3 Watertight sewer lines	6 Seepage pit	9 Feedyard	13 Insecticide storage	
Direction from well?		How many feet?		

FROM	TO	CODE	LITHOLOGIC LOG	FROM	TO	PLUGGING INTERVALS
<b>0</b>	<b>5</b>	<b>CH</b>	<b>Clay, with silt, dark brown</b>			
<b>5</b>	<b>18</b>	<b>CL</b>	<b>Clay, with silt, light brown</b>			
<b>18</b>	<b>18.5</b>		<b>Sandstone</b>			
<b>18.5</b>	<b>24</b>	<b>SP</b>	<b>Sand, with clay, fine grained</b>			
<b>24</b>	<b>25</b>	<b>CH</b>	<b>Clay, gray</b>			

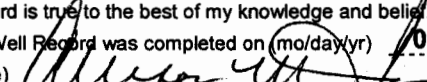7 CONTRACTOR'S OR LANDOWNER'S CERTIFICATION: This water well was <b>(1) constructed</b> , (2) reconstructed, or (3) plugged under my jurisdiction and was completed on (mo/day/yr) <b>08/06/07</b> and this record is true to the best of my knowledge and belief. Kansas
Water Well Contractor's License No. <b>531</b> This Water Well Record was completed on (mo/day/yr) <b>09/06/07</b>
under the business name of <b>Geotechnical Services, Inc.</b> by (signature) 

INSTRUCTIONS: Please fill in blanks and circle the correct answers. Send three copies to Kansas Department of Health and Environment, Bureau of Water, 1000 SW Jackson St., Ste. 420, Topeka, Kansas 66612-1367. Telephone: 913-296-5545. Send one to WATER WELL OWNER and retain one for your records.