

Acc 224

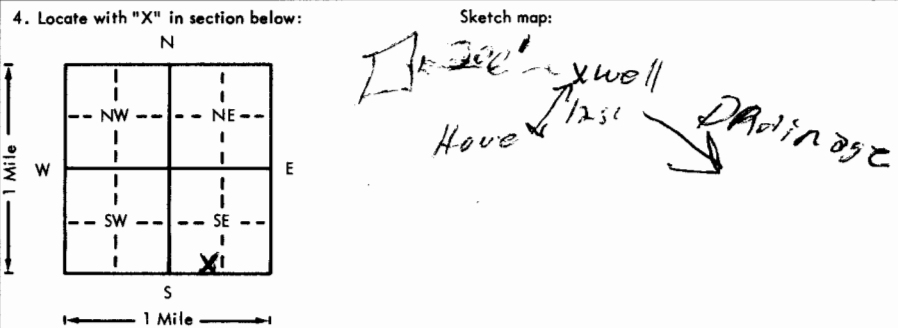
HILL CITY MO

USE TYPEWRITER OR BALL POINT PEN-PRESS FIRMLY, PRINT CLEARLY.

WATER WELL RECORD
KSA 82a-1201-1215

Kansas Department of Health and Environment-Division of Environment
(Water well Contractors)
Topeka, Kansas 66620

DCD

1. Location of well: County <u>Graham</u> Fraction <u>SE 1/4 SW 1/4 SE 1/4</u> Section number <u>13</u> Township number <u>T 7 S</u> Range number <u>R 23 E/W</u>	
2. Distance and direction from nearest town or city: <u>5 mi x 1/2 mi East of Hill City, Mo</u> Street address of well location if in city: <u></u>	
3. Owner of well: <u>Rag Wolf</u> R.R. or street: <u>RA</u> City, state, zip code: <u>Hill City, Kan</u>	
4. Locate with "X" in section below: Sketch map: 	
6. Bore hole dia. <u>9</u> in. Completion date <u>8-22-76</u> Well depth <u>64</u> ft.	
7. <input checked="" type="checkbox"/> Cable tool <input checked="" type="checkbox"/> Rotary <input type="checkbox"/> Driven <input type="checkbox"/> Dug <input type="checkbox"/> Hollow rod <input type="checkbox"/> Jetted <input type="checkbox"/> Bored <input type="checkbox"/> Reverse rotary	
8. Use: <input checked="" type="checkbox"/> Domestic <input type="checkbox"/> Public supply <input type="checkbox"/> Industry <input type="checkbox"/> Irrigation <input type="checkbox"/> Air conditioning <input type="checkbox"/> Stock <input type="checkbox"/> Lawn <input type="checkbox"/> Oil field water <input type="checkbox"/> Other	
Casing: Material <u>CORON 2 3/8" D</u> Weight: Above or below <u>24</u> in. Threading <u>Welded</u> Surface <u>3</u> lbs./ft. RMP <u>PVC</u> Weight <u>3</u> lbs./ft. Dia. <u>5</u> in. to <u>64</u> ft. depth Wall Thickness: inches or Dia. <u></u> in. to <u></u> ft. depth gage No. <u>1250</u>	
10. Screens: Manufacturer's name <u>Jess L Lovell</u> Type <u>plastic</u> Dia. <u>5"</u> Slot/gauze <u>1/8"</u> Length <u>10'</u> Set between <u>54</u> ft. and <u>64</u> ft. <u></u> ft. and <u></u> ft. Gravel pack? <input checked="" type="checkbox"/> Size range of material <u>4/20/30</u>	
11. Static water level: <u>36</u> ft. below land surface Date <u>8-2-76</u> mo./day/yr.	
12. Pumping level below land surfaces: <u>Not pumped</u> <u>2</u> hrs. pumping <u></u> g.p.m. <u></u> ft. after <u></u> hrs. pumping <u></u> g.p.m. Estimated maximum yield <u></u> g.p.m.	
13. Water sample submitted: <u></u> mo./day/yr. Yes <input checked="" type="checkbox"/> No <input type="checkbox"/> Date <u></u>	
14. Well head completion: Pitless adapter <u></u> inches above grade <input checked="" type="checkbox"/> Well grouted? <u>yes</u> With: <u></u> Neat cement <input checked="" type="checkbox"/> Bentonite <input type="checkbox"/> Concrete Depth: From <u>0</u> ft. to <u>12</u> ft.	
16. Nearest source of possible contamination: ft. <u>200</u> Direction <u>West</u> Type <u>Open lot</u> Well disinfected upon completion? <input checked="" type="checkbox"/> Yes <input type="checkbox"/> No	
17. Pump: <input checked="" type="checkbox"/> Not installed Manufacturer's name <u></u> Model number <u></u> HP <u></u> Volts <u></u> Length of drop pipe <u></u> ft. capacity <u></u> g.p.m. Type: <input type="checkbox"/> Submersible <input type="checkbox"/> Turbine <input type="checkbox"/> Jet <input type="checkbox"/> Reciprocating <input type="checkbox"/> Centrifugal <input type="checkbox"/> Other	
18. Elevation: <u>2285</u> Topography: <input type="checkbox"/> Hill <input checked="" type="checkbox"/> Slope <input type="checkbox"/> Upland <input type="checkbox"/> Valley	
19. Remarks: <u>9, 2285 Top of m</u> <u>63</u> <u>2222</u>	
20. Water well contractor's certification: This well was drilled under my jurisdiction and this report is true to the best of my knowledge and belief. Business name <u>DLB Drilling Co 303</u> License No. <u></u> Address <u>Hill City, Kan</u> Signed <u>Allen Poomi</u> Date <u>8-22-76</u> Authorized representative	

7-230
R
W
E
13
SE
USE
1/4 1/4 1/4 1/4

Forward the white, blue and pink copies to the Department of Health and Environment

Form WWC-5