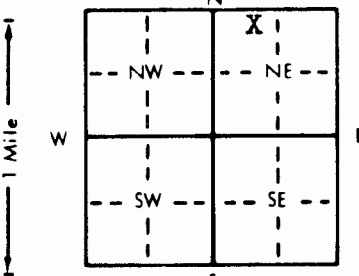


1 LOCATION OF WATER WELL: Fraction **NE 1/4 NE 1/4 NW 1/4** Section Number **33** Township Number **T 7 S** Range Number **R 24 E/W**
 County: **GRAHAM**

Distance and direction from nearest town or city street address of well if located within city?
4 MILES NORTH AND 1 1/2 WEST OF PENOKEE, KS

2 WATER WELL OWNER: **LAUREL GODDARD**
 RR#, St. Address, Box # : _____ Board of Agriculture, Division of Water Resources
 City, State, ZIP Code : **PENOKEE, KS 67659** Application Number: _____

3 LOCATE WELL'S LOCATION WITH AN "X" IN SECTION BOX:

 4 DEPTH OF COMPLETED WELL: **70** ft. ELEVATION: _____
 Depth(s) Groundwater Encountered 1. **50** ft. 2. _____ ft. 3. _____ ft.
 WELL'S STATIC WATER LEVEL: **50** ft. below land surface measured on mo/day/yr **10-05-94**
 Pump test data: Well water was _____ ft. after _____ hours pumping _____ gpm
 Est. Yield **40** gpm: Well water was _____ ft. after _____ hours pumping _____ gpm
 Bore Hole Diameter: **10** in. to **70** ft., and _____ in. to _____ ft.
 WELL WATER TO BE USED AS:
 Domestic 3 Feedlot 6 Oil field water supply 9 Dewatering 12 Other (Specify below)
 2 Irrigation 4 Industrial 7 Lawn and garden only 10 Monitoring well
 Was a chemical/bacteriological sample submitted to Department? Yes _____ No If yes, mo/day/yr sample was submitted _____
 Water Well Disinfected? Yes _____ No

5 TYPE OF BLANK CASING USED:
 Steel 3 RMP (SR) 6 Asbestos-Cement 9 Other (specify below) Welded _____
 PVC 4 ABS 7 Fiberglass _____ Threaded _____
 Blank casing diameter: **5** in. to **70** ft., Dia _____ in. to _____ ft., Dia _____ in. to _____ ft.
 Casing height above land surface: **30** in., weight **160** lbs./ft. Wall thickness or gauge No. _____
 TYPE OF SCREEN OR PERFORATION MATERIAL:
 Steel 3 Stainless steel 5 Fiberglass 8 RMP (SR) 11 Other (specify) _____
 2 Brass 4 Galvanized steel 6 Concrete tile 9 ABS 12 None used (open hole)
 SCREEN OR PERFORATION OPENINGS ARE:
 1 Continuous slot Mill slot 6 Wire wrapped 9 Drilled holes
 2 Louvered shutter 4 Key punched 7 Torch cut 10 Other (specify) _____
 SCREEN-PERFORATED INTERVALS: From **40** ft. to **70** ft., From _____ ft. to _____ ft.
 GRAVEL PACK INTERVALS: From **40** ft. to **70** ft., From _____ ft. to _____ ft.

6 GROUT MATERIAL: 1 Neat cement 2 Cement grout Bentonite 4 Other _____
 Grout Intervals: From **0** ft. to **30** ft., From _____ ft. to _____ ft., From _____ ft. to _____ ft.
 What is the nearest source of possible contamination:
 1 Septic tank 4 Lateral lines 7 Pit privy 10 Livestock pens 14 Abandoned water well
 2 Sewer lines 5 Cess pool 8 Sewage lagoon 11 Fuel storage 15 Oil well/Gas well
 3 Watertight sewer lines 6 Seepage pit 9 Feedyard 12 Fertilizer storage 16 Other (specify below) _____
 Direction from well? _____ How many feet? _____

FROM	TO	LITHOLOGIC LOG	FROM	TO	PLUGGING INTERVALS
0	6	Surface Clay			
6	16	Fine Sand			
16	22	Hard Clay			
22	30	White Hard Rock			
30	40	Fine Sand			
40	50	Med. Sand			
50	60	Med. to Large Sand			
60	68	Med. Sand			
68	70	Flint Rock			

7 CONTRACTOR'S OR LANDOWNER'S CERTIFICATION: This water well was (1) constructed, (2) reconstructed, or (3) plugged under my jurisdiction and was completed on (mo/day/year) **10-05-94** and this record is true to the best of my knowledge and belief. Kansas Water Well Contractor's License No. **444** This Water Well Record was completed on (mo/day/yr) **10-05-94** under the business name of **ANDERSON DRILLING** by (signature) *Andy Anderson*

OFFICE USE ONLY T R E W SEC 1/4 1/4 1/4